


STATE OF KANSAS
STATE CORPORATION COMMISSION

WELL PLUGGING RECORD

Give All Information Completely
Make Required Affidavit
Mail or Deliver Report to
Conservation Division
State Corporation Comm.
245 North Water
Wichita, KS 67202

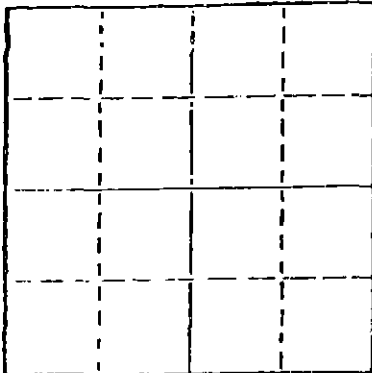

Locate well correctly on above
Section Plot

Hodgeman County. Sec. 32 Twp. 22S Rge. 22W E/W
Location as "NE/CNW $\frac{1}{4}$ SW $\frac{1}{4}$ " or footage from lines
NE ~~NE~~ NW

Lease Owner Kennedy & Mitchell, Inc.
Lease Name Ewy Well No. 37-598
Office Address 7400 W. Jefferson, Denver, Col. 80235
Character of Well (Completed as Oil, Gas or Dry Hole)

Dry

Date Well completed Feb. 11, 19 81
Application for plugging filed Feb. 10, 19 81
Application for plugging approved Feb. 10, 19 81
Plugging commenced Feb. 11, 19 81
Plugging completed Feb. 11, 19 81
Reason for abandonment of well or producing formation

Dry

If a producing well is abandoned, date of last production 19

Was permission obtained from the Conservation Division or
its agents before plugging was commenced? Yes

Name of Conservation Agent who supervised plugging of this well Clarence Thomas
Producing formation Depth to top Bottom Total Depth of Well X
Show depth and thickness of all water, oil and gas formations.

OIL, GAS OR WATER RECORDS

CASING RECORD

FORMATION	CONTENT	FROM	TO	SIZE	PUT IN	PULLED OUT
		0	316	8 5/8		

Describe in detail the manner in which the well was plugged, indicating where the mud fluid
was placed and the method or methods used in introducing it into the hold. If cement or other
plugs were used, state the character of same and depth placed, from feet to
feet for each plug set.

Plugged:

60 sacks @ 900

35 sacks @ 330

10 sacks @ 40

5 sacks in rathole; 5 sacks in mousehole

Cemented by Allied Cementing

2-26-81

RECEIVED

STATE CORPORATION COMMISSION

FEB 26 1981

(If additional description is necessary, use BACK of this sheet)

Name of Plugging Contractor DaMac Drilling Inc.
Box 1164, Great Bend, Kansas

STATE OF Kansas COUNTY OF Barton, ss.

Martha J. McKown (employee of owner) or (owner or operator)
of the above-described well, being first duly sworn on oath, says: That I have knowledge of
the facts, statements, and matters herein contained and the log of the above-described well
as filed and that the same are true and correct. So help me God.

(Signature)

Martha J. McKown


Box 1164, Great Bend, Kansas 67530
(Address)

SUBSCRIBED AND SWORN TO before me this 11th day of Feb., 1981

Vada L. Sullivan

Notary Public.

My commission expires

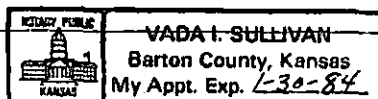

WELL LOG

COMPANY Kennedy & Mitchell, Inc.

SEC. 32 T. 22S R. 22W

FARM Ewy

NO. 37-598

LOC. NE NW


TOTAL DEPTH 4600 RTD

COUNTY Hodgeman, Kansas

COMM. 2-3-81

COMP. 2-11-81

CONTRACTOR DaMac Drilling Inc.

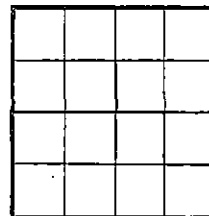

CASING 8 5/8 set @ 316'

ELEVATION

PRODUCTION P&A

FIGURES INDICATE BOTTOM OF FORMATIONS

Post Rock, Shale	0	316
RedBed, Shale	316	1410
Lime, Shale	1410	4600 RTD

RECEIVED
STATE CORPORATION COMMISSION

FEB 26 1981

CORPORATION DIVISION
Wichita, Kansas

State of KansasCounty of Barton


SS

I, Martha J. McKown of DaMac Drilling Inc.upon oath state the above and foregoing is a true and correct copy of the log of the Ewy 37-598 well.

Martha J. McKown

Subscribed and sworn to before me this 11th day of Feb. 19 81

My Commission Expires:

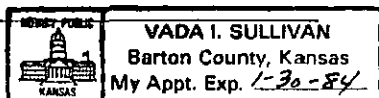

Vada I. Sullivan
NOTARY PUBLIC