


WELL PLUGGING RECORD

Give All Information Completely  
Make Required Affidavit  
Mail or Deliver Report to:  
Conservation Division  
State Corporation Commission  
211 No. Broadway  
Wichita, Kansas

Hodgeman County. Sec 33 Twp 22S Rge. (E) 22 (W)  
Location as "NE/CNW/SW" or footage from lines C NW NW  
Lease Owner Pickrell Drilling Company  
Lease Name Sebes A Well No. 1  
Office Address 705 Fourth Natl Bk Bldg, Wichita 2, Kansas  
Character of Well (completed as Oil, Gas or Dry Hole) Dry Hole  
Date well completed 8-24-62 August 24 1962  
Application for plugging filed August 24 1962  
Application for plugging approved August 24 1962  
Plugging commenced August 24 1962  
Plugging completed August 24 1962  
Reason for abandonment of well or producing formation Dry Hole

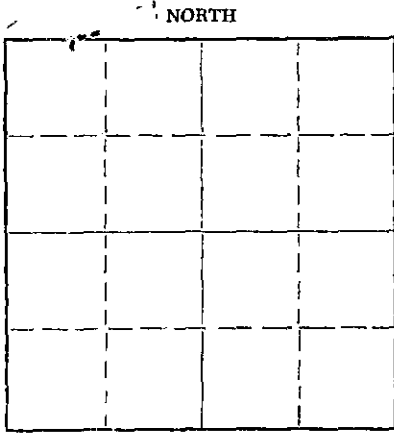

Locate well correctly on above  
Section Plat

If a producing well is abandoned, date of last production \_\_\_\_\_ 19\_\_\_\_  
Was permission obtained from the Conservation Division or its agents before plugging was commenced? Yes

Name of Conservation Agent who supervised plugging of this well Frank Broadfoot  
Producing formation \_\_\_\_\_ Depth to top \_\_\_\_\_ Bottom \_\_\_\_\_ Total Depth of Well 4519 Feet  
Show depth and thickness of all water, oil and gas formations.

OIL, GAS OR WATER RECORDS

CASING RECORD

FORMATION	CONTENT	FROM	TO	SIZE	PUT IN	PULLED OUT
				8 5/8"	240"	None

Describe in detail the manner in which the well was plugged, indicating where the mud fluid was placed and the method or methods used in introducing it into the hole. If cement or other plugs were used, state the character of same and depth placed, from \_\_\_\_\_ feet to \_\_\_\_\_ feet for each plug set.

Heavy mud to 235'. Set plug. Cemented with  
20 sacks cement. Heavy mud to 40'. Set Plug.  
Cemented with 10 sacks cement to bottom of  
cellar. Plugged rat hole with 2 sacks cement.

9-10-62  
**RECEIVED**  
STATE CORPORATION COMMISSION  
SEP 10 1962  
CONSERVATION DIVISION  
Wichita, Kansas

(If additional description necessary, use BACK of this sheet)  
Name of Plugging Contractor Pickrell Drilling Company  
Address 705 Fourth National Bank Bldg, Wichita 2, Kansas

STATE OF KANSAS, COUNTY OF SEDGWICK, ss.  
C. W. SEBITS (employee of owner) or (owner or operator) of the above-described well, being first duly sworn on oath, says: That I have knowledge of the facts, statements, and matters herein contained and the log of the above-described well as filed and that the same are true and correct. So help me God.

(Signature) C. W. Sebits  
705 4th Nat'l Bk Bldg, Wichita 2, Ks.  
(Address)

SUBSCRIBED AND SWORN TO before me this 4th day of September, 1962

Maxine Blackman  
Maxine Blackman  
Notary Public.

My commission expires June 21, 1966

ROTARY DRILLING LOG

COMPANY: Pickrell Drilling Company  
 705 Fourth National Bank Bldg.  
 Wichita 2, Kansas  
 LOCATION: Sebes "A" #1 C. NW NW 33-22S-22W,  
 Hodgeman County, Kansas  
 Rotary Drilling Commenced 8-13-62  
 Rotary Drilling Completed 8-24-62

CONTRACTOR: PICKRELL DRILLING COMPANY  
 Wichita, Kansas

CASING RECORD: (12 jts) 8 5/8" Surface Casing set at 240', cemented with 190 sacks cement. Circulated. Completed 6:30 8-13-62, P.M. No oil string run. D & A.

LOG

(Figures indicate bottom of formation — measurements from top of rotary bushing.)

115	Top Soil - Clay	<u>Circulated for Samples</u>
190	Yellow Clay	4410'
240	Blue Shale	4463'
345	Shale	4505'
370	Pyrite	4519'
510	Shale Sand	
850	Red Beds	
1035	Sand	<u>Slope Tests</u>
1380	Red Beds - Shale	2500'
1395	Anhydrite	3000'
1480	Shale & shells	3500'
2240	Lime Shale	4000'
2385	Lime	
2805	Lime & shale	
3555	Lime	<u>S. L. M.</u>
3700	Lime, shale & Sand	3700'
3920	Lime	4105'
3995	Lime & Shale	4300'
4105	Lime	
4495	Mississippian	
4519	Miss. Chert R. T. D.	

RECEIVED  
 STATE CORPORATION COMMISSION  
 SEP 10 1962  
 CONSERVATION DIVISION  
 Wichita, Kansas

The undersigned, C. W. Sebits, Attorney-in-Fact for PICKRELL DRILLING COMPANY, hereby certifies in behalf of said Company, that the above is a true and correct log of the formation encountered in drilling the above well as reflected by the Daily Drilling Reports.

PICKRELL DRILLING COMPANY  
 By C. W. Sebits Attorney-in-Fact

STATE OF KANSAS }  
 COUNTY OF SEDGWICK } ss.

On this 4th day of September, 19 62, before me the undersigned, a Notary Public, in and for the County and State aforesaid, personally appeared C. W. SEBITS, to me known to be the identical person who subscribed the name of PICKRELL DRILLING COMPANY to the foregoing instrument as its Attorney-in-Fact and acknowledged to me that he executed the same as his free and voluntary act and deed, and as the free and voluntary act and deed of such company, for the uses and purposes therein set forth.

Given under my hand and seal of office the day and year last above written.

My commission expires: June 21, 1966

Maxine Blackman  
 Notary Public