


STATE OF KANSAS  
STATE CORPORATION COMMISSION

Form CP-4

Give All Information Completely  
Make Required Affidavit  
Mail or Deliver Report to:  
Conservation Division  
State Corporation Commission  
212 No. Market  
Wichita, Kansas

WELL PLUGGING RECORD

Hodgeman County. Sec. 33 Twp. 22S Rge. 22W (E) (W)  
Location as "NE/CNW/SW" or footage from lines: Approx. SW SE  
Lease Owner Francis Oil & Gas, Inc.  
Lease Name Dimmick Well No. 1  
Office Address 905 Palace Bldg., Tulsa, Okla. 74103  
Character of Well (completed as Oil, Gas or Dry Hole) Dry Hole  
Date well completed April 24 19 69  
Application for plugging filed April 24 19 69  
Application for plugging approved April 24 19 69  
Plugging commenced April 24 19 69  
Plugging completed April 24 19 69  
Reason for abandonment of well or producing formation Dry Hole

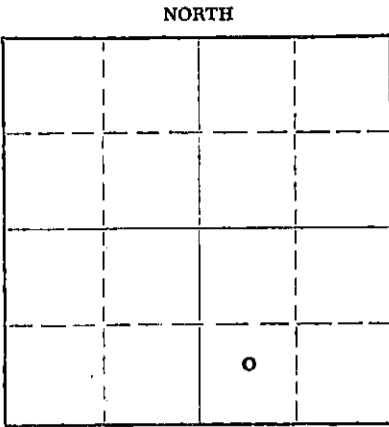

Locate well correctly on above Section Plat

If a producing well is abandoned, date of last production \_\_\_\_\_ 19\_\_\_\_  
Was permission obtained from the Conservation Division or its agents before plugging was commenced? Yes

Name of Conservation Agent who supervised plugging of this well Hugh E. Scott, Sublette, Kansas  
Producing formation \_\_\_\_\_ Depth to top \_\_\_\_\_ Bottom \_\_\_\_\_ Total Depth of Well 4434 Feet  
Show depth and thickness of all water, oil and gas formations.

OIL, GAS OR WATER RECORDS

CASING RECORD

FORMATION	CONTENT	FROM	TO	SIZE	PUT IN	PULLED OUT
		0	281'	8 5/8"	281'	None

Describe in detail the manner in which the well was plugged, indicating where the mud fluid was placed and the method or methods used in introducing it into the hole. If cement or other plugs were used, state the character of same and depth placed, from \_\_\_\_\_ feet to \_\_\_\_\_ feet for each plug set.

Plug: 850'/85 sacks cement  
280'/30 sacks cement  
30'/10 sacks cement


RECEIVED  
STATE CORPORATION COMMISSION  
MAY 2 1969  
CONSERVATION DIVISION  
Wichita, Kansas

(If additional description is necessary, use BACK of this sheet)

Name of Plugging Contractor Hellar Drilling Company, Inc.  
Address 339 Union Center Bldg., Wichita, Kansas 67202

STATE OF Kansas, COUNTY OF Sedgwick, ss.  
D. L. Hellar, Pres. of Hellar Drilling Company, Inc. (employee of owner) or (owner or operator) of the above-described well, being first duly sworn on oath, says: That I have knowledge of the facts, statements, and matters herein contained and the log of the above-described well as filed and that the same are true and correct. So help me God.

(Signature) D. L. Hellar D. L. Hellar, President  
339 Union Center Bldg., Wichita, Kansas 67202  
(Address)

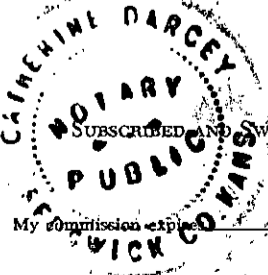

SUBSCRIBED AND SWORN TO before me this 30th day of April, 19 69  
March 25, 1972  
Catherine Darcey - Notary Public.

DRILLER'S LOG

COMPANY: Francis Oil & Gas, Inc., Tulsa, Okla.  
 CONTRACTOR: Hellar Drilling Company, Inc., Wichita, Kansas  
 LEASE: #1 Dimmick  
 LOCATION: Approx. SW SE 33-22S-22W, Hodgeman County, Kansas  
 COMMENCED: April 15, 1969  
 COMPLETED: April 24, 1969  
 CASING: Set 8 5/8" Surface Casing @ 281'/285 sacks cement

0-70	Sand Shale
70-283	Shale
283-689	Shale & Red Bed
689-700	Anhydrite
700-1235	Sand & Shale
1235-1311	Shale & Red Bed
1311-1344	Anhydrite
1344-1710	Shale, Red Bed & Shell
1710-2110	Shale
2110-2380	Shale & Lime
2380-4066	Lime & Shale
4066-4434	Lime
4434	Rotary Total Depth

D & A

RECEIVED  
 STATE CORPORATION COMMISSION  
 MAY 2 1969  
 CONSERVATION DIVISION  
 Wichita, Kansas

STATE OF KANSAS        )  
                               )    SS  
 COUNTY OF SEDGWICK    )

I, D. L. Hellar, do hereby certify that the above and foregoing is a true and correct copy of the log of the #1 Dimmick, located in Approx. SW SE 33-22S-22W, Hodgeman County, Kansas, as reflected by the files of the Hellar Drilling Company, Inc.

HELLAR DRILLING COMPANY, INC.

By *D. L. Hellar*  
 President - D. L. Hellar

Subscribed and sworn to before me, a Notary Public, in and for Sedgwick County, Kansas, this 30th day of April, 1969.

*Catherine Darcey*  
 Notary Public - Catherine Darcey

My Commission Expires:  
 March 25, 1972.

