


STATE OF KANSAS
STATE CORPORATION COMMISSION

WELL PLUGGING RECORD

Give All Information Completely
Make Required Affidavit
Mail or Deliver Report to
Conservation Division
State Corporation Comm.
245 North Water
Wichita, KS 67202

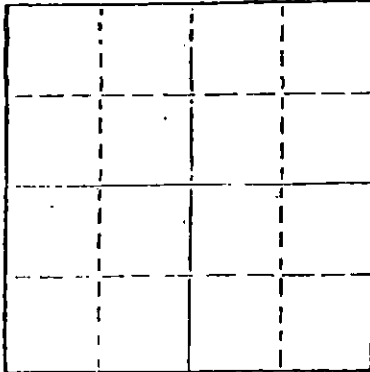

Locate well correctly on above
Section Plot

Hodgeman County. Sec. 18 Twp. 22S Rge. 23W
Location as "NE/CNW1SW1" or footage from lines

C-NW SE SW

Lease Owner E. K. Edmiston

Lease Name Bradshaw

Well No. 1

Office Address 800 Vickers K.S.B.&T. Bldg., Wichita, KS

Character of Well (Completed as Oil, Gas or Dry Hole) 67202

Dry Hole

Date Well completed October 1, 1978

Application for plugging filed Verbal Application 19

Application for plugging approved Verbal Approval 19

Plugging commenced October 1, 1978

Plugging completed October 1, 1978

Reason for abandonment of well or producing formation

If a producing well is abandoned, date of last production 19

Was permission obtained from the Conservation Division or its agents before plugging was commenced? Yes

Name of Conservation Agent who supervised plugging of this well Clarence Thomas

Producing formation Depth to top Bottom Total Depth of Well 4,670'

Show depth and thickness of all water, oil and gas formations.

OIL, GAS OR WATER RECORDS

CASING RECORD

FORMATION	CONTENT	FROM	TO	SIZE	PUT IN	PULLED OUT
				8-5/8"	377'	None

Describe in detail the manner in which the well was plugged, indicating where the mud fluid was placed and the method or methods used in introducing it into the hold. If cement or other plugs were used, state the character of same and depth placed, from feet to feet for each plug set.

Filled hole with heavy rotary mud from 4,670 ft. (rotary total depth) to 1,000 ft. Set plug at 1,000 Ft. and cemented with 50 sacks cement. Filled hole with heavy rotary mud from 1,000 ft. to 360 ft. Set plug at 360 ft. and cemented with 35 sacks cement. Filled hole with heavy rotary mud from 360 ft. to 40 ft. Set solid plug at 40 ft. and cemented to cellar with 10 sacks cement, 5 sacks cement in rat hole.

Plugging operations accomplished utilizing Sun Oil Well cementing pump truck through 4 1/2 inch drill pipe.

(If additional description is necessary, use BACK of this sheet)

Name of Plugging Contractor Sun Oilwell Cementing, Inc.
Box 169, Great Bend, Kansas 67530

STATE OF Kansas COUNTY OF Sedgwick ss.

Dean Britting, Agent

XXXXXX of owner XXXXX of operator

of the above-described well, being first duly sworn on oath, says: That I have knowledge of the facts, statements, and matters herein contained and the log of the above-described well as filed and that the same are true and correct. So help me God.

(Signature) Dean Britting

200 N. Main, Wichita, Kansas 67202

(Address)

SUBSCRIBED AND SWORN TO before me this 4th day of October, 1978

Elsie Willison
Elsie Willison - Notary Public.

My commission expires July 25, 1982

RECEIVED
STATE CORPORATION COMMISSION

OCT - 5 1978

10-5-78

CONSERVATION DIVISION
Wichita, Kansas

KANSAS DRILLERS LOG

COMPANY E. K. Edmiston

SEC. 18 T. 22S R. 23W

FARM Bradshaw

NO. 1

LOC. C- NW SE SW

COUNTY Hodgeman

ROTARY TOTAL DEPTH 4,670'

COMM. September 21, 1978

COMP. October 1, 1978

CONTRACTOR H-30, Inc.

ISSUED October 4, 1978

CASING

10 3/4"

8 5/8" Set at 376' cemented w/185 sxs cement

ELEVATION 2,392' K.B.

5 1/2"

4 1/2"

FIGURES INDICATE BOTTOM OF FORMATIONS

Sand and Shale	365'
Shale	924'
Shale and Sand	1,600'
Shale	1,612'
Anhydrite	1,645'
Shale	1,860'
Shale and Lime	2,485'
Lime and Shale	2,730'
Lime	2,910'
Lime and Shale	3,240'
Lime	4,670'
Rotary Total Depth	4,670'

RECEIVED
STATE CORPORATION COMMISSION

OCT - 5 1978

CONSERVATION DIVISION
Wichita, Kansas

I hereby certify the above and foregoing to be
a true and correct log of the above described
well as shown by the drilling reports.

H-30, Inc.

Dean Britting
Dean Britting

State of Kansas

County of Sedgwick

ss:

Subscribed and Sworn to before me a Notary Public

in and for said county and state this 4th day of

October, 1978.

NOTARY

WILLIS

HODGEMAN

SEPT 20 1978

My Commission Expires:

July 25, 1982

Elsie Willison
Elsie Willison - Notary Public