


STATE OF KANSAS
STATE CORPORATION COMMISSION
200 Colorado Derby Bldg
Wichita, Kansas 67202

Form CP-4
Rev. 12-15-80

WELL PLUGGING RECORD

Give All Information Completely
Make Required Affidavit

COUNTY Hodgeman SEC. 18 TWP. 22S RGE. 23 N/W
Location as in quarters or footage from lines:
C NW NW

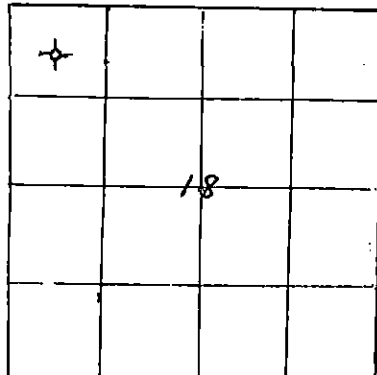

Locate Well
correctly on above
Section Platt.

Lease Owner American Energies Corporation
Lease Name Reed Well No. 1
Office Address 575 Fourth Financial Center Wichita, Ks. 67202
Character of Well (Completed as Oil, Gas or Dry Hole): Dry
Date Well Completed 1-30-84
Application for plugging filed 1-30-84
Plugging commenced 1-30-84
Plugging completed 1-30-84
Reason for abandonment of well or producing formation _____

Was permission obtained from the Conservation Division or it's
Agent's before plugging was commenced? Yes

Name of Conservation Agent who supervised plugging of this well Robert Tarbulton
Producing formation _____ Depth to top _____ bottom _____ T.D. 4732'
Show depth and thickness of all water, oil and gas formations.

OIL, GAS OR WATER RECORDS

Casing Record

Formation	Content	From	To	Size	Put in	Pulled Out
				8 5/8"	412'	NONE

Describe in detail the manner in which the well was plugged, indicating where the mud fluid was placed and the method or methods used in introducing it into the hold. If cement or other plugs were used, state the character of same and depth placed, from _____ feet to _____ feet for each plug set.

Spotted 50 sx. cement @ 1650' thru drill pipe.
Spotted 50 sx. cement @ 650' thru drill pipe.
Spotted 50 sx. cement @ 450' thru drill pipe.
Set solid bridge plug @ 40'. Spotted 10 sx. cement thru drill pipe.
Spotted 15 sx. cement in rathole.

(If additional description is necessary, use BACK of this sheet)

Name of Plugging Contractor White & Ellis Drilling, Inc.
401 E. Douglas, Suite 500, Wichita, Ks. 67202

STATE OF Kansas COUNTY OF Sedgwick, ss.
Ernest Sifford (employee of owner) or (owner or operator) of the
above-described well, being first duly sworn on oath, says: That I have knowledge of the
facts, statements, and matters herein contained and the log of the above-described well as
filed and that the same are true and correct. So help me God.

(Signature) Michael L. Conditine
401 E. Douglas #500 Wichita
(Address) Kansas 67202

SUBSCRIBED AND SWORN TO before me this

22nd day of February, 1984



David F. Jamis Notary Public.


My Commission expires: _____

STATE CORPORATION COMMISSION

FFR 2 4 1984

2-24-84

CONSERVATION DIVISION
Wichita, Kansas

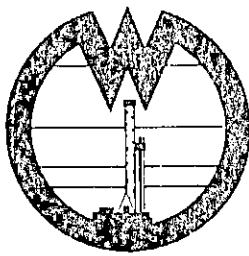

15.083-21111-0000

WHITE

AND ELLIS DRILLING, Inc.

DRILLERS LOG

OPERATOR: American Energies Corporation 575 Fourth Financial Center Wichita, Ks. 67202

CONTRACTOR: White & Ellis Drilling, Inc., 401 E. Douglas, Suite 500,
Wichita, Ks. 67202Lease Name Reed Well No. 1Sec. 18 T. 22S R. 23W Spot C NW NWCounty Hodgeman State Kansas Elevation

Casing Record:

Surface: 8 5/8" @ 412' with 220 SX. 2% gel
3%ccProduction: @ with SX.Type Well: D & A Total Depth 4732'Drilling Commenced 1-17-84 Drilling Completed 1-30-84

Formation	From	To	Tops
Cellar	0	7	
Shale	7	900	
Shale, Lime	900	4732	

RECEIVED
STATE CORPORATION COMMISSION

FEB 24 1984

CONSERVATION DIVISION
Wichita, Kansas