

ORIGINAL

STATE CORPORATION COMMISSION OF KANSAS
OIL & GAS CONSERVATION DIVISION
RECOMPLETION FORM
AC0-2 AMENDMENT TO WELL HISTORY

API NO. 15- 083-21,199-00-02

County Hodgeman

SE SE SW Sec 18 Twp 22S Rge 23W X East

330 Ft North from Southeast Corner of Section
2970 Ft West from Southeast Corner of Section
(Note: Locate well in section plat below)


Lease Name Bradshaw Well # 1A

Field Name Nova

Name of New Formation Same formation

Elevation: Ground 2371 KB 2376

Section Plat

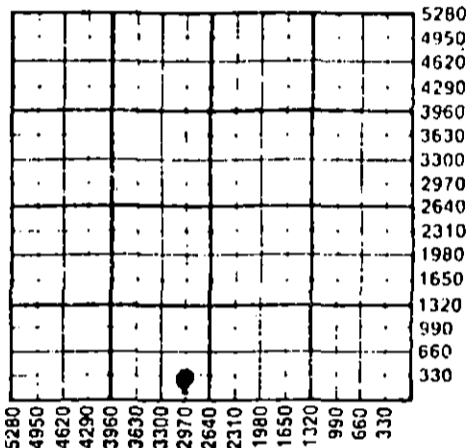

Operator: License # 30527
Name: Genesis Petroleum, Inc.
Address P.O. Box 146

City/State/Zip Jetmore, Ks. 67854

Purchaser Texaco

Operator Contact Person Arthur G. Ramos
Phone (316) 357-6265

Designate Type of Original Completion
 New Well Re-Entry Workover

Oil SWD Temp Abd
 Gas Inj Delayed Comp.
 Dry Other (Core, Water Supply etc.)

Date of Original Completion: 7-15-85

DATE OF RECOMPLETION:
11-07-90 Commenced 11-27-90 Completed

Designate Type of Recompletion/Workover:

Deepening Delayed Completion
 Plug Back Re-perforation
 Conversion to Injection/Disposal

Is recompleted production:
 Commingled; Docket No. _____
 Dual Completion; Docket No. _____
 Other (Disposal or Injection)?

K.C.C. OFFICE USE ONLY

F Letter of Confidentiality Attached
C Wireline Log Received
C Drillers Time Log Received

Distribution

KCC SWD/Rep NGPA
 KGS Plug Other
(Specify)

.....
.....

INSTRUCTIONS: This form shall be completed in triplicate and filed with the Kansas Corporation Commission, 200 Colorado Derby Building, Wichita, Kansas 67202, within 120 days of the recompletion of any well. Rules 82-3-107 and 82-3-141 apply. Information on side two of this form will be held confidential for a period of 12 months if requested in writing and submitted with the form. See rule 82-3-107 for confidentiality in excess of 12 months. One copy of any additional wireline logs and driller's time logs (not previously submitted) shall be attached with this form. Submit AC0-4 prior to or with this form for approval of commingling or dual completions. Submit CP-4 with all plugged wells. Submit CP-111 with all temporarily abandoned wells. NOTE: Conversion of wells to either disposal or injection must receive approval before use; submit form U-1.

All requirements of the statutes, rules and regulations promulgated to regulate the oil and gas industry have been fully complied with and the statements herein are complete and correct to the best of my knowledge.

Signature Arthur G. Ramos Title Pres. Date 12-10-90
DEC 12 1990

Subscribed and sworn to before me this 10th day of December 19 90

Notary Public Stacy C. Olson II Date Commission Expires 6-21-93



81

SIDE TWO

Operator Name Genesis Petroleum, Inc. Lease Name Bradshaw Well # 1A

Sec 18 Twp 22S Rge 23W East West County Hodgeman

RECOMPLETED FORMATION DESCRIPTION:

 Log Sample

Acid.w/500 ^{Name} gals. same original zone ; swabbed-back ^{Top} 94 ^{Bottom} barrels
(30% oil, 70% wtr.)

ADDITIONAL CEMENTING/SQUEEZE RECORD

Purpose:	Depth		Type of Cement	# Sacks Used	Type & Percent Additives
	Top	Bottom			
Perforate					
Protect Casing					
Plug Back TD					
Plug Off Zone					

Shots Per Foot	PERFORATION RECORD	Acid, Fracture, Shot, Cement Squeeze Record
	Specify Footage of Each Interval Perforated	(Amount and Kind of Material Used)
		500 gals. Mca Acid w/inhibitors

PBTD none Plug Type

TUBING RECORD:

Size 2 3/8" Set At 4644 Packer At none Was Liner Run? Y X N

Date of Resumed Production, Disposal or Injection 11-27-90

Estimated Production Per 24 Hours 10 bbl/oil 65 bbl/water

 MCF gas gas-oil ratio

NOV 27 1990
HODGEMAN COUNTY, KS