

STATE OF KANSAS
STATE CORPORATION COMMISSION

WELL PLUGGING RECORD

Give All Information Completely
Make Required Affidavit
Mail or Deliver Report to
Conservation Division
State Corporation Comm.
245 North Water
Wichita, KS 67202

Hodgeman County. Sec. 20 Twp. 22S Rge. 22 E/W
Location as "NE/CNW 1/4 SW 1/4" or footage from lines
50' south of C-NW/4 of SW/4


Lease Owner Sun Exploration & Production Co.
Lease Name S. Bamberger Well No. 1
Office Address P. O. Box 35567-Tulsa, Oklahoma 74135
Character of Well (Completed as Oil, Gas or Dry Hole) Oil

Date Well completed October 3 19 62
Application for plugging filed September 30 19 81
Application for plugging approved November 10 19 81
Plugging commenced January 13 19 82
Plugging completed March 5 19 82

Reason for abandonment of well or producing formation
Temporary abandoned
If a producing well is abandoned, date of last production
January 19 79

Was permission obtained from the Conservation Division or
its agents before plugging was commenced? Yes

Name of Conservation Agent who supervised plugging of this well Steve Durrant
Producing formation Marmaton Depth to top 4282 Bottom 4286 Total Depth of Well 4625
Show depth and thickness of all water, oil and gas formations.

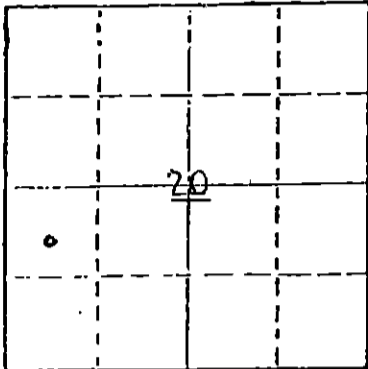

Locate well correctly on above
Section Plat

OIL, GAS OR WATER RECORDS

CASING RECORD

FORMATION	CONTENT	FROM	TO	SIZE	PUT IN	PULLED OUT
Marmaton	Oil	4282	4286	5-1/2"	4624	1221'
Mississippi	Oil	4506	4522	5-1/2"	4624	--
NOTE: Mississippi plugged off w/BP set at 4850'.						

Describe in detail the manner in which the well was plugged, indicating where the mud fluid was placed and the method or methods used in introducing it into the hold. If cement or other plugs were used, state the character of same and depth placed, from 4282 feet to 4022 feet for each plug set.

Pump 30 Sx. cement plug down 5-1/2" csg. Displace to 4022' (bottom 4282'). Shot 5-1/2" csg. at 3606'-3100'-2610'-2105-1600'. Could not pull free. Shot 1221'. Pull out of hole w/1221' 5-1/2" csg. Waiting on top plug. Pump 4 Sx. hulls & 140 Sx. Pozmix into hole. Dug out & cut off surface csg. 4' below GL. Fill w/5 Sx. cement. Weld on steel plate. Back fill cellar & clean up location.

3-22-82

RECEIVED
STATE CORPORATION COMMISSION

(If additional description is necessary, use BACK of this sheet)

Name of Plugging Contractor Halliburton & kelso Casing Pullers

MAR 22 1982

STATE OF Oklahoma COUNTY OF Tulsa
S. Weaver (employee of owner)

CONSERVATION DIVISION
Wichita Kansas

of the above-described well, being first duly sworn on oath, says: That I have knowledge of the facts, statements, and matters herein contained and the log of the above-described well as filed and that the same are true and correct. So help me God.

(Signature) S. Weaver
P. O. Box 35567-Tulsa, Oklahoma 74135
(Address)

SUBSCRIBED AND SWORN TO before me this 19 day of March, 19 82

Mae Wix
Notary Public.

My commission expires October 2, 1983

