

STATE OF KANSAS
STATE CORPORATION COMMISSION

CORRECTED

Form CP-4

Give All Information Completely
Make Required Affidavit
Mail or Deliver Report to:
Conservation Division
State Corporation Commission

WELL PLUGGING RECORD

P. O. Box 17027
Wichita, Kansas 67217
NORTH

Hodgeman County, Sec. 20 Twp. 22 Rge. (E) 22 (W)

Location as "NE/CNW/SW" or footage from lines C NE SW

Lease Owner Sun Oil Company

Lease Name Bamberger Well No. 12

Office Address P.O. Box 67, Hays, Kansas 67601

Character of Well (completed as Oil, Gas or Dry Hole) oil

Date well completed 19

Application for plugging filed 19

Application for plugging approved 19


Plugging commenced June 18 19 74

Plugging completed June 28 19 74

Reason for abandonment of well or producing formation depleted

If a producing well is abandoned, date of last production 19

Was permission obtained from the Conservation Division or its agents before plugging was commenced? YES

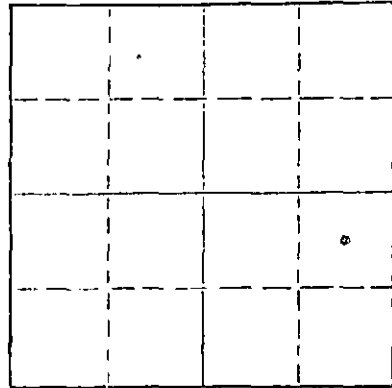

Locate well correctly on above Section Plat

Name of Conservation Agent who supervised plugging of this well Edgar J. Eves

Producing formation Depth to top Bottom Total Depth of Well 4535 Feet

Show depth and thickness of all water, oil and gas formations.

OIL, GAS OR WATER RECORDS

CASING RECORD

FORMATION	CONTENT	FROM	TO	SIZE	PUT IN	PULLED OUT
		0	260'	8 5/8"	260'	none
			4522'	5 1/2"	4522'	3555.55

Describe in detail the manner in which the well was plugged, indicating where the mud fluid was placed and the method or methods used in introducing it into the hole. If cement or other plugs were used, state the character of same and depth placed, from feet to feet for each plug set.

Sanded back to 4500' and dumped 5 sacks of cement.

Allied Cementing Company plugged well pumping in 18 sacks of gel and 120 sacks of cement.

7-8-74
RECEIVED
STATE CORPORATION COMMISSION
JUL 8 1974

RECEIVED
STATE CORPORATION COMMISSION
JUL 3 1974
CONSERVATION DIVISION
Wichita, Kansas

CONSERVATION DIVISION
Wichita, Kansas

Name of Plugging Contractor PIPE PULLERS, INC.
Address Box 486, Ellinwood, Kansas 67526

STATE OF KANSAS COUNTY OF BARTON
Evelyn Roth (employee of owner) or (owner or operator) of the above-described

well, being first duly sworn on oath, says: That I have knowledge of the facts, statements, and matters herein contained and the log of the above-described well as filed and that the same are true and correct. So help me God.

(Signature) Evelyn Roth
Ellinwood, Kansas (Address)

SUBSCRIBED AND SWORN to before me this 2nd day of July 1974

My commission expires Feb. 10, 1975
Sergeant Meyer Notary Public

Sunray DX Oil Company
Tulsa, Oklahoma

Tulsa, Oklahoma
July 8, 1963

Contractor: Stickle Drilling Company
Date Commenced: June 26, 1963
Date Completed: July 5, 1963

Bamberger No. 12
NE SW Section 20-22S-22W
Hodgeman County, Kansas

DRILLER'S LOG

Depth Figures Indicate Base of Formation:

Shale	2455
Shale and lime	2615
Lime and shale	2830
Shale and lime	3002
Lime and shale	3302
Shale and lime	4063
Lime and shale	4110
Shale and lime	4243
Lime	4433
Lime and shale	4453
Lime	4535 TD

RECEIVED
STATE CORPORATION COMMISSION
DEC 14 1973
CONSERVATION DIVISION
Wichita, Kansas

I, Fred E. Stickle, hereby certify the above to be a true and complete Driller's Log of Sunray DX Oil Company's Bamberger No. 12 well, NE SW of Section 20-22S-22W, Hodgeman County, Kansas

Fred E. Stickle
FRED E. STICKLE

M. Hensley
Notary Public

My Commission Expires January 11, 1967