

Give All Information Completely
Make Required Affidavit
Mail or Deliver Report to:
Conservation Division
State Corporation Commission
212 No. Market
Wichita, Kansas

WELL PLUGGING RECORD

Hodgeman County, Sec. 20 Twp. 22 Rge. (E) 22 (W)

Location as "NE/CNW/SW" or footage from lines SW SE

Lease Owner Sun Oil Company

Lease Name Bamberger Well No. 8

Office Address 800 Security Life Bldg.

Character of Well (completed as Oil, Gas or Dry Hole) Oil

Date well completed 4-3 19 63

Application for plugging filed 12-12 19 73

Application for plugging approved 12-14 19 73


Plugging commenced 8-29 19 74

Plugging completed 9-5 19 74

Reason for abandonment of well or producing formation Depleted

If a producing well is abandoned, date of last production 19

Was permission obtained from the Conservation Division or its agents before plugging was commenced? Yes

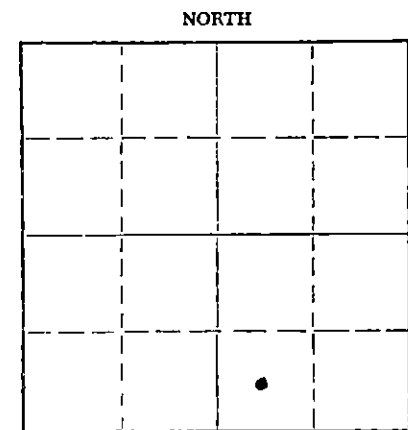

Locate well correctly on above Section Plat

Name of Conservation Agent who supervised plugging of this well Edgar Eves

Producing formation Mississippi Depth to top 4502 Bottom 4511 Total Depth of Well 4610 Feet

Show depth and thickness of all water, oil and gas formations.

OIL, GAS OR WATER RECORDS

CASING RECORD

FORMATION	CONTENT	FROM	TO	SIZE	PUT IN	PULLED OUT
				8 5/8	251	-
				5 1/2	4609	2589

Describe in detail the manner in which the well was plugged, indicating where the mud fluid was placed and the method or methods used in introducing it into the hole. If cement or other plugs were used, state the character of same and depth placed, from feet to feet for each plug set.

Plugged back with sand to 4480. Dumped 4 sx of cement on sand with dump bailer. Shot casing off at 2589'. Pulled and layed down 2589' of 5 1/2" casing. Plugged with 80 sx cement, 14 sx gel, 30 sx cement, 8 sx gel, and 10 sx cement. Plug at surface.

RECEIVED
STATE CORPORATION COMMISSION
SEP 30 1974
CONSERVATION DIVISION
Wichita, Kansas

(If additional description is necessary, use BACK of this sheet)
Name of Plugging Contractor Charlie Crow Drilling Co.
Address Box 706, Hays, Kansas.

STATE OF COLORADO COUNTY OF DENVER, ss.
D. A. Coppedge (employee of owner) or (owner or operator) of the above-described well, being first duly sworn on oath, says: That I have knowledge of the facts, statements, and matters herein contained and the log of the above-described well as filed and that the same are true and correct. So help me God.

(Signature) [Signature]
800 Security Life Bldg., Denver, Co. 80202
(Address)

SUBSCRIBED AND SWORN TO before me this 25th day of September, 19 74

[Signature] Notary Public.

623-62

Sunray DX Oil Company
Tulsa, Oklahoma

15-083-10301-0000

Tulsa, Oklahoma
April 8, 1963

Contractor: Stickle Drilling Company
Date Commenced: March 20, 1963
Date Completed: April 3, 1963

Bamberger No. 8
SW SE Sec. 20-22S-22W
Hodgeman County, Kansas

DRILLER'S LOG

Depth Figures Indicate Base of Formation:

Shale	2190
Lime and shale	2276
Shale and lime	2620
Lime and shale	2990
Shale and lime	3235
Shale	3406
Shale with chalk streaks	3608
Shale and lime	3870
Lime and shale	3963
Shale and lime	4092
Lime with shale	4146
Lime	4492
Coring	4549
Mississippi chert	4551
Coring	4560
Chert	4561
Coring	4570
Chert	4571
Coring	4578
Lime	4610 TD

RECEIVED
STATE CORPORATION COMMISSION
DEC 14 1973
CONSERVATION DIVISION
Wichita, Kansas

I, Fred E. Stickle, hereby certify the above to be a true and complete Driller's Log of Sunray DX Oil Company's Bamberger No. 8, SW SE Sec. 20-22S-22W, Hodgeman County, Kansas.

Fred E. Stickle
Fred E. Stickle

A. Mensley
Notary Public

My Commission Expires January 11, 1967