


Give All Information Completely
Make Required Affidavit
Mail or Deliver Report to:
Conservation Division
State Corporation Commission
212 No. Market
Wichita, Kansas

WELL PLUGGING RECORD

Hodgeman County, Sec. 20 Twp. 22 Rge. (E) 22 (W)

Location as "NE/CNW%SW%" or footage from lines SE SW
Lease Owner Sun Oil Company
Lease Name Bamberger Well No. 4
Office Address 800 Security Life Bldg.
Character of Well (completed as Oil, Gas or Dry Hole) Oil
Date well completed 12/28 19 62
Application for plugging filed 12/12 19 73
Application for plugging approved 12/14 19 73
Plugging commenced 9/12 19 74
Plugging completed 9/18 19 74
Reason for abandonment of well or producing formation Depleted

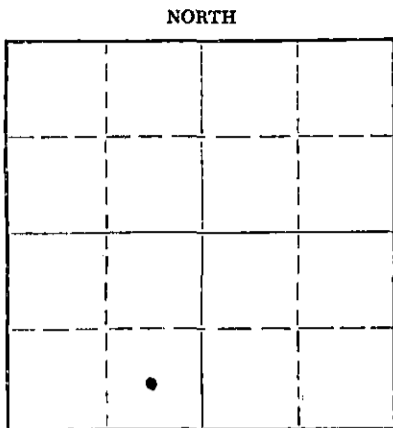

Locate well correctly on above Section Plat

If a producing well is abandoned, date of last production 19
Was permission obtained from the Conservation Division or its agents before plugging was commenced? Yes

Name of Conservation Agent who supervised plugging of this well Edgar Eves
Producing formation Mississippi Depth to top 4528 Bottom 4540 Total Depth of Well 4540 Feet
Show depth and thickness of all water, oil and gas formations.

OIL, GAS OR WATER RECORDS

CASING RECORD

FORMATION	CONTENT	FROM	TO	SIZE	PUT IN	PULLED OUT
				8 5/8	272	-
				5 1/2	4528	2590

Describe in detail the manner in which the well was plugged, indicating where the mud fluid was placed and the method or methods used in introducing it into the hole. If cement or other plugs were used, state the character of same and depth placed, from feet to feet for each plug set.

Set sand plug at 4490
Plugged back with sand to 4490. Dumped 45 sx cement on plug.
Shot pipe off at 2596. Pull and layed down 2596 ft. 5 1/2" casing.
Plugged with 80 sx cement, 14 sx gel, 30 sx cement, 85 sx gel, and 10 sx cement.
Plug at surface

RECEIVED
STATE CORPORATION COMMISSION
SEP 30 1974
CONSERVATION DIVISION
Wichita, Kansas

(If additional description is necessary, use BACK of this sheet)

Name of Plugging Contractor Charlie Crow Drilling Co.
Address Box 706, Hays, Kansas

STATE OF COLORADO, COUNTY OF DENVER, ss.
D. A. Coppedge (employee of owner) or (owner or operator) of the above-described well, being first duly sworn on oath, says: That I have knowledge of the facts, statements, and matters herein contained and the log of the above-described well as filed and that the same are true and correct. So help me God.

(Signature) [Signature]
800 Security Life Bldg., Denver, Co. 80202
(Address)

SUBSCRIBED AND SWORN TO before me this 25th day of September, 1974

My commission expires Nov. 22, 1975 Notary Public.

Sunray DX Oil Company
Tulsa, Oklahoma

Tulsa, Oklahoma
January 4, 1963

Contractor: Stickle Drilling Company
Date Commenced: December 16, 1962
Date Completed: December 28, 1962

Bamberger No. 4
Center SE SW Section 20-22S-22W
Hodgeman County, Kansas

DRILLER'S LOG

Depth Figures Indicate Base of Formation:

Surface clay	273
Shale	920
Dakota sand	1075
Red bed	1743
Shale and lime	2605
Lime	2815
Lime and shale	3118
Shale	3290
Shale and lime	3455
Shale	3790
Shale and lime	4022
Lime and shale	4082
Shale and lime	4135
Lime and shale	4237
Lime	4274
Shale and lime	4371
Lime	4540 TD

RECEIVED
STATE CORPORATION COMMISSION
DEC 14 1973
CONSERVATION DIVISION
Wichita, Kansas

I, Fred E. Stickle, hereby certify the above to be a true and complete Driller's Log of Sunray DX Oil Company's Bamberger No. 4, Center SE SW Section 20-22S-22W, Hodgeman County, Kansas.

Fred E. Stickle
FRED E. STICKLE

Mary E. Brown
Notary Public

My Commission expires:
August 18, 1965