


STATE OF KANSAS
STATE CORPORATION COMMISSION

Form CP-4

Give All Information Completely
Make Required Affidavit
Mail or Deliver Report to:
Conservation Division
State Corporation Commission
P. O. Box 17027
Wichita, Kansas 67217
NORTH

WELL PLUGGING RECORD

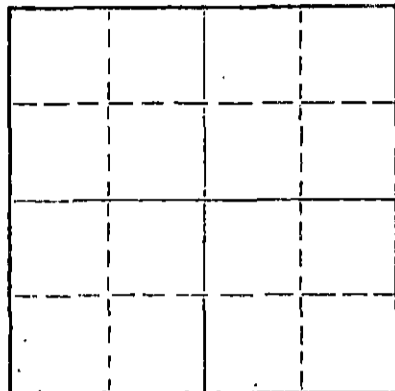

Locate well correctly on above
Section Plat

Hodgman County, Sec. 19 Twp. 22 Rge. 22 (E) (W)
Location as "NE/CNWSW" or footage from lines SW NE
Lease Owner Braden Deem, Inc.
Lease Name Oppy #1 Well No.
Office Address Wichita, Kansas
Character of Well (completed as Oil, Gas or Dry Hole)
Date well completed 19
Application for plugging filed 19
Application for plugging approved 19
Plugging commenced 9/8/72 19
Plugging completed 2/21/73 19
Reason for abandonment of well or producing formation depleted

If a producing well is abandoned, date of last production 19
Was permission obtained from the Conservation Division or its agents before plugging was commenced? yes

Name of Conservation Agent who supervised plugging of this well Eves
Producing formation Depth to top Bottom Total Depth of Well 4631 Feet
Show depth and thickness of all water, oil and gas formations.

OIL, GAS OR WATER RECORDS

CASING RECORD

FORMATION	CONTENT	FROM	TO	SIZE	PUT IN	PULLED OUT
				8-5/8	257	none
				5 1/2"	4630	2225'

Describe in detail the manner in which the well was plugged, indicating where the mud fluid was placed and the method or methods used in introducing it into the hole. If cement or other plugs were used, state the character of same and depth placed, from feet to feet for each plug set.

Checked hole, sanded hole to 4260', set 5 sacks cement.
Shot pipe at 3990', 3503', 3024', 2567', 2341', 2247', milled 70 joints. Allied pumped 8 sacks gel, 70 sacks cement, 7 sacks gel and 50 sacks cement to plug well.
PLUGGING COMPLETE.

RECEIVED
STATE CORPORATION COMMISSION
MAR 6 1973
CONSERVATION DIVISION
Wichita, Kansas

(If additional description is necessary, use BACK of this sheet)
Name of Plugging Contractor KNIGHT CASTING PULLING CO., INC.
Address CHASE, KANSAS

STATE OF KANSAS, COUNTY OF RICE, ss.
NOEL J. KNIGHT (employee of owner) or (owner or operator) of the above-described well, being first duly sworn on oath, says: That I have knowledge of the facts, statements, and matters herein contained and the log of the above-described well as filed and that the same are true and correct. So help me God.

(Signature) Noel J. Knight
CHASE, KANSAS
(Address) 73

SUBSCRIBED AND SWORN TO before me this 1st day of March, 1973

My commission expires
MARGARET MELCHER
NOTARY PUBLIC
Rice County, Kansas
My Commission Expires
Feb. 15, 1975

Margaret Melcher
Notary Public.

WELL LOG

COMPANY SUNRAY MID-CONTINENT OIL COMPANY

SEC. 19 T. 22S R. 22W

FARM OPPY

NO. 1

LOC. C-SW, NE


TOTAL DEPTH 4630'

COUNTY HODGEMAN CO., KANSAS

COMM. December 15, 1961

COMP. January 2, 1962

CONTRACTOR GARVEY DRILLING COMPANY

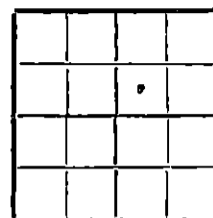

CASING 8-5/8" @ 257' w/200 sax.
5 1/2" @ 4629' w/100 sax.

ELEVATION 2299' DF

PRODUCTION

FIGURES INDICATE BOTTOM OF FORMATIONS

258	Surface clay, sand & blue shale
823	Shale
835	Anhydrite
890	Shale
1025	Shale & sand
1425	Shale & shells w/sadd streaks
1680	Shale & shells
2360	Shale & lime
2690	Lime
2985	Shale & lime
3135	Shale & chalky lime
3320	Shale & lime
3840	Lime & shale
4251	Lime
4300	Shale & lime
4395	Lime
4520	Lime & shale
4550	Lime
4599	Lime & chert
4630	Lime
4630	T. D.

RECEIVED
STATE CORPORATION COMMISSION

AUG 29 1962

CONSERVATION DIVISION
Wichita, Kansas

State of KANSAS
County of BARTON } ss

I, VERNE A. MORRIS of GARVEY DRILLING COMPANY

upon oath state the above and foregoing is a true and correct copy of the log of the #1 OPPY well.

Verne A. Morris

Subscribed and sworn to before me this 18th day of January 1962

My Commission Expires November 12, 1962

[Signature]
NOTARY PUBLIC

