


STATE OF KANSAS
STATE CORPORATION COMMISSION

Form CP-4

WELL PLUGGING RECORD

Give All Information Completely
Make Required Affidavit
Mail or Deliver Report to:
Conservation Division
State Corporation Commission
212 No. Market
Wichita, Kansas

NORTH

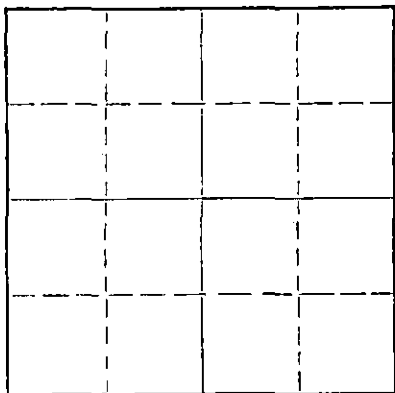

Locate well correctly on above
Section Plat

Hodgeman County, Sec. 11 Twp. 22 Rge. 22 (E) W (W)

Location as "NE/CNW/SW" or footage from lines C-SW-SW

Lease Owner L. J. Dreiling & Sons, Inc.

Lease Name Heimer Well No. 1

Office Address Victoria, Kansas

Character of Well (completed as Oil, Gas or Dry Hole) Dry

Date well completed 10-8 19 66

Application for plugging filed 10-8 19 66

Application for plugging approved 10-8 19 66

Plugging commenced 10-8 19 66

Plugging completed 10-8 19 66

Reason for abandonment of well or producing formation Dry

If a producing well is abandoned, date of last production 19

Was permission obtained from the Conservation Division or its agents before plugging was commenced? Yes

Name of Conservation Agent who supervised plugging of this well Edgar Eves, Sublett, Kansas

Producing formation Depth to top Bottom Total Depth of Well 1500 Feet

Show depth and thickness of all water, oil and gas formations.

OIL, GAS OR WATER RECORDS

CASING RECORD

FORMATION	CONTENT	FROM	TO	SIZE	PUT IN	PULLED OUT
Surface Pipe				8 5/8	225'	

Describe in detail the manner in which the well was plugged, indicating where the mud fluid was placed and the method or methods used in introducing it into the hole. If cement or other plugs were used, state the character of same and depth placed, from feet to feet for each plug set.

Filled hole with Rotary mud to a depth of 700' where 1st. plug was set using 30 sacks cement. Filling hole with Rotary Mud to a depth of 275' where 2nd. plug was set using 10 sacks cement. Rotary Mud was used to fill hole to a depth of 40' where 3rd. plug was set using 10 sacks cement and filling hole to surface.

RECEIVED
STATE CORPORATION COMMISSION
OCT 12 1966
CONSERVATION DIVISION
Wichita, Kansas

(If additional description is necessary, use BACK of this sheet)

Name of Plugging Contractor L. J. Dreiling & Sons, Inc.

Address Route #2, Victoria, Kansas

STATE OF Kansas, COUNTY OF Ellis, ss.

(employee of owner) or (owner or operator) of the above-described well, being first duly sworn on oath, says: That I have knowledge of the facts, statements, and matters herein contained and the log of the above-described well as filed and that the same are true and correct. So help me God.

(Signature) Leo F. Dreiling

Leo F. Dreiling Victoria, Kansas

(Address)

SUBSCRIBED AND SWORN to before me this 10 day of October, 19 66

My commission expires October 26, 1968

Elmer Weltz

Notary Public.

L. J. DREILING and SONS, Inc.
VICTORIA, KANSAS

WELL LOG

Company	L. J. Dreiling & Sons, Inc.	Sec.	11	Twp.	22	Rng.	22
	Victoria, Kansas						
Farm	Heimer	No.	#1	Location	C-SW-SW		
Total Depth	4500'			County	Hodgeman		
Comm.	9-28-66	Comp.	10-8-66		2191'	K.B.	
				Elevation:	2191'	D.F.	
Contractor	L. J. Dreiling & Sons, Inc.				2189'	G.R.	

Casing Record

Cement Record

Production:

225' 8-5/8"

125 Sacks

D & A

Figures Indicate Bottom of Formations

0'	168'	168'	Top Soil & Clay
168'	225'	225'	Clay-Sand-Gravel
225'	415'	415'	Shale
415'	450'	450'	Sand
450'	790'	790'	Shale
790'	995'	995'	Sand
995'	1300'	1300'	Sand
1300'	1361'	1361'	Red Bed
1361'	1398'	1398'	Anhy.
1398'	1910'	1910'	Shale & Shells
1910'	2308'	2308'	Shale & Shells
2308'	2413'	2413'	Lime
2413'	2525'	2525'	Lime
2525'	2570'	2570'	Lime & Shale
2570'	2690'	2690'	Lime
2690'	2825'	2825'	Shale & Lime w/chalk strks.
2825'	2962'	2962'	Shale & Lime w/chalk strks.
2962'	3105'	3105'	Shale & Lime
3105'	3321'	3321'	Shale w/lime & chalk strks.
3321'	3431'	3431'	Shale, lime & chalk strks.
3431'	3595'	3595'	Shale & Lime
3595'	3758'	3758'	Shale & Lime
3758'	3820'	3820'	Shale & Lime
3820'	3930'	3930'	Lime
3930'	4007'	4007'	Lime
4007'	4103'	4103'	Lime
4103'	4165'	4165'	Lime
4165'	4250'	4250'	Lime

RECEIVED
 STATE CORPORATION COMMISSION
 OCT 12 1966
 CONSERVATION DIVISION
 Wichita, Kansas

L. J. DREILING and SONS, Inc.
VICTORIA, KANSAS

WELL LOG

Company L. J. Dreiling & Sons, Inc.
Victoria, Kansas

Sec. 11 Twp. 22 Rng. 22

Farm Heimer No. #1

Location C-SW-SW

Total Depth 4500'

County Hodgeman

Comm. 9-28-66

Comp. 10-8-66

Elevation: 2194' K.B.
2191' D.F.

Contractor L. J. Dreiling & Sons, Inc.

2189' G.R.

Casing Record

Cement Record

Production:

225' 8-5/8"

125 Sacks

D & A

Figures Indicate Bottom of Formations

4250'
4320'
4385'
4460'
4500'

4320'
4385'
4460'
4500'
R.T.D.

Lime
Lime
Lime
Lime

RECEIVED
STATE CORPORATION COMMISSION

OCT 12 1966

CONSERVATION DIVISION
Wichita, Kansas

STATE OF KANSAS)
COUNTY OF ELLIS) 88

I, Leo F. Dreiling, of the L. J. Dreiling & Sons, Inc. upon oath states that the above and foregoing is a true and correct copy from the Daily Drilling Report from your Heimer #1.

Leo F. Dreiling
LEO F. DREILING

Subscribed and sworn to before me this 10th day of October, 1966.

Elmer Wetz
NOTARY PUBLIC

My Commission expires: October 26, 1968