


STATE OF KANSAS  
STATE CORPORATION COMMISSION  
CONSERVATION DIVISION  
P. O. BOX 17027  
WICHITA, KANSAS 67217

WELL PLUGGING RECORD

Hodgeman County, Sec. 11 Twp. 22 Rge. 22 (E) W (W)  
Location as "NE/CNW/SW" or footage from lines C SW NW  
Lease Owner Pickrell Drlg. Co. ; Wichita, Ks. 67202  
Lease Name Hoffman Well No. #A-1  
Office Address 705 4th National Bank Building  
Character of Well (completed as Oil, Gas or Dry Hole) Oil  
Date well completed March 1 1974  
Application for plugging filed April 1975  
Application for plugging approved April 1975  
Plugging commenced April 15 1975  
Plugging completed May 5 1975  
Reason for abandonment of well or producing formation Depleted

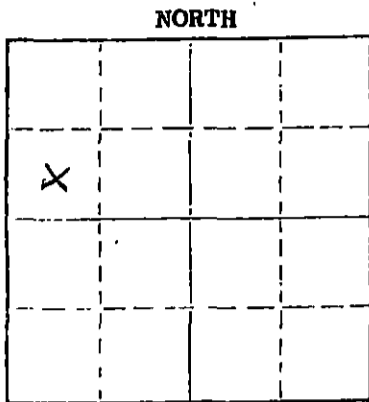

Locate well correctly on above Section Plot

If a producing well is abandoned, date of last production Nov. 22 1974  
Was permission obtained from the Conservation Division or its agents before plugging was commenced? Yes

Name of Conservation Agent who supervised plugging of this well Leo Massey  
Producing formation Mississippian Depth to top 4440 Bottom TD in Mississippian Depth of Well 4455  
Show depth and thickness of all water, oil and gas formations.

OIL, GAS OR WATER RECORDS

CASING RECORD

FORMATION	CONTENT	FROM	TO	SIZE	PUT IN	PULLED OUT
Mississippian	Oil & water	4440	4455	8 5/8"	224	None
				5 1/2"	4447	2814

Describe in detail the manner in which the well was plugged, indicating where the mud fluid was placed and the method or methods used in introducing it into the hole. If cement or other plugs were used, state the character of same and depth placed, from feet to feet for each plug set.

April 15, 1975 Plugged off bottom. Dumped sand to 4300'. Mixed and dumped 5 sx of cement.

May 5, 1975 Plugged off top. Allied Cementing Co. mixed and pumped down 8 5/8" surface casing; 20 sx of gel, 75 sx of cement, 4 sx of gel and 20 sx of cement.

(If additional description is necessary, use BACK of this sheet)

Name of Plugging Contractor RUSS CASING PULLING, INC.  
Address P. O. Box 1082 ; Great Bend, Kansas 67530

STATE OF Kansas COUNTY OF Sedgwick ss.  
Jack Gurley

(employee of owner) or (owner or operator) of the above-described well, being first duly sworn on oath, says: That I have knowledge of the facts, statements, and matters herein contained and the log of the above-described well as filed and that the same are true and correct. So help me God.

(Signature) Jack Gurley  
705 4th National Bk. Bldg. Wichita, Ks. 67202  
(Address)

SUBSCRIBED AND SWORN TO before me this 21 day of July 1975

My commission expires August 19, 1975  
Helen L. Martin Notary Public.

HELEN L. MARTIN  
NOTARY PUBLIC  
Sedgwick County, Kans.  
My Comm. Expires Aug. 19, 1975

RECEIVED  
STATE CORPORATION COMMISSION

JUL 21 1975

CONSERVATION DIVISION  
Wichita, Kansas


**COMPANY:** Pickrell Drilling Company  
 705 Fourth National Bank Bldg.  
 Wichita, Kansas 67202

**LOCATION:** Hoffman "A" No. 1, C SW NW  
 Sec. 11-22S-22W, Hodgeman County, Kansas

Rotary Drilling Commenced 12/26/73  
 Rotary Drilling Completed 1/8/74

**CONTRACTOR:** **PICKRELL DRILLING COMPANY**  
 Wichita, Kansas

**CASING RECORD:** Run 5 jts. 8 5/8" surface casing set at 220' K.B. Cemented with 150 sx cement. Completed 6:15 P.M., December 26, 1973. Circulated.

Run 143 jts. 5 1/2" casing set at 4447'. Cemented with 125 sx 50-50 Pozmix 4% gel & 50 sx common. Completed 3:45 P.M., January 8, 1974.

**LOG**

(Figures indicate bottom of formation — measurements from top of rotary bushing.)

150	Top Soil		<u>C. F. S.</u>
815	Shale		4243
1005	Sand		4285
1150	Shale		4420
1371	Shale & Shells		4430
1415	Anhydrite		4439
1963	Shale & Shells		4452
2130	Shale		4457
2275	Shale & Lime Stringers		
2930	Lime & Shale		
3090	Shale & Lime Stringers		<u>S. L. M.</u>
3355	Shale & Lime	Strap	3878.24
3590	Shale	Board	3874.86
4439	Shale & Lime		3.38 Difference
4457	Lime, Mississippi, RTD		
			<u>Slope Tests</u>
			3500
			4000

RECEIVED  
 STATE CORPORATION COMMISSION  
 APR 3 1975  
 CONSERVATION DIVISION  
 Wichita, Kansas

The undersigned, C. W. Sebitts, Attorney-in-Fact for PICKRELL DRILLING COMPANY, hereby certifies in behalf of said Company, that the above is a true and correct log of the formation encountered in drilling the above well as reflected by the Daily Drilling Reports.

PICKRELL DRILLING COMPANY  
 By [Signature]  
 C. W. Sebitts Attorney-in-Fact

STATE OF KANSAS }  
 COUNTY OF SEDGWICK } ss.:

On this 15th day of January, 1974, before me the undersigned, a Notary Public, in and for

the County and State aforesaid, personally appeared C. W. Sebitts, to me known to be the identical person who subscribed the name of PICKRELL DRILLING COMPANY to the foregoing instrument as its Attorney-in-Fact and acknowledged to me that he executed the same as his free and voluntary act and deed, and as the free and voluntary act and deed of such company, for the uses and purposes therein set forth.

Given under my hand and seal of office the day and year last above written.

My commission expires: August 19, 1975

[Signature]  
 Helen L. Martin Notary Public