


STATE OF KANSAS
STATE CORPORATION COMMISSION

Form CP-4

Give All Information Completely
Make Required Affidavit
Mail or Deliver Report to:
Conservation Division
State Corporation Commission
212 No. Market
Wichita, Kansas 67202

WELL PLUGGING RECORD

NORTH

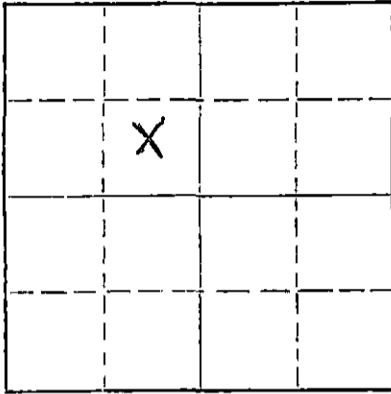

Locate well correctly on above
Section Plat

Hodgeman County, Sec. 25 Twp. 22 Rge. 22 (E) W (W)
Location as "NE/CNW/SW" or footage from lines C SE NW
Lease Owner Pickrell Drilling Co.; Wichita, Ks. 67202
Lease Name Ruff 'A' Well No. #1
Office Address 705 Fourth National Bank Building
Character of Well (completed as Oil, Gas or Dry Hole) Oil
Date well completed Sept. 19 1970
Application for plugging filed August 31 1970
Application for plugging approved August 31 1970
Plugging commenced September 2 1970
Plugging completed September 9 1970
Reason for abandonment of well or producing formation Depleted

If a producing well is abandoned, date of last production July 31 1970
Was permission obtained from the Conservation Division or its agents before plugging was commenced? Yes

Name of Conservation Agent who supervised plugging of this well Edgar Eves
Producing formation Mississippian Depth to top 450' Bottom 4515' Total Depth of Well 4515' Feet
Show depth and thickness of all water, oil and gas formations.

OIL, GAS OR WATER RECORDS

CASING RECORD

FORMATION	CONTENT	FROM	TO	SIZE	PUT IN	PULLED OUT
				8 5/8	280	None
				5 1/2	4506	2424

RECEIVED
STATE CORPORATION COMMISSION
OCT 15 1970
CONSERVATION DIVISION
Wichita, Kansas

Describe in detail the manner in which the well was plugged, indicating where the mud fluid was placed and the method or methods used in introducing it into the hole. If cement or other plugs were used, state the character of same and depth placed, from _____ feet to _____ feet for each plug set.

September 2, 1970 Plugged off bottom. Dumped sand to 4480'. Mixed and dumped 5 sx of cement to 4440'.
September 9, 1970 Plugged off top. Globe Oil Well Cementing Co. mixed and pumped down 8 5/8" surface casing: 10 sx gel, released plug, mixed and pumped 80 sx of cement--- 7 sx gel - 30 sx of cement - 3 sx gel - 10 sx of cement.

(If additional description is necessary, use BACK of this sheet)

Name of Plugging Contractor RUSS CASING PULLING, INC
Address P. O. BOX 1082; GREAT BEND, KANSAS 67530

STATE OF Kansas, COUNTY OF Sedgwick, ss.
Dale M. Robinson (employee of owner) or (owner or operator) of the above-described well, being first duly sworn on oath, says: That I have knowledge of the facts, statements, and matters herein contained and the log of the above-described well as filed and that the same are true and correct. So help me God.

(Signature) Dale M. Robinson
Dale M. Robinson
705 Fourth National Bank Building
Wichita, Kansas (Address)



SUBSCRIBED AND SWORN to before me this 13th day of October, 1970
Esther Lamone
Esther Lamone Notary Public.
My commission expires January 19, 1973

ROTARY DRILLING LOG

COMPANY: PICKRELL DRILLING COMPANY
4th National Bank Bldg.
Wichita, Kansas

Rotary Drilling Commenced 8-30-68

Rotary Drilling Completed 9-8-68

LOCATION: Ruff "A" No. 1 C SE NW Sec. 25-22S-22W
Hodgeman County, Kansas

CONTRACTOR: PICKRELL DRILLING COMPANY
Wichita, Kansas

CASING RECORD: Ran 7 jts. used 20# 8 5/8" casing 280 set @ 280' KB. 160 sacks cement.
Completed 8:15 PM, Circ.
Ran 140 jts. 5 1/2" 14# & 15.5# casing set 9' off bottom at 4506' KB.

LOG

(Figures indicate bottom of formation — measurements from top of rotary bushing.)

20	Post rock	C. F. S.
280	Shale & Sand Streaks	4445'
560	Shale & Red Bed	4515'
748	Shale & Shells	
764	Blain	
850	Shale & Shells	
1040	Sand	
1396	Shale & Shells	Slope Tests
1430	Anhydrite	2000
1730	Shale & Shells & Lime Streaks	2500
2530	Lime & Shale	3000
2785	Lime	4000
3700	Lime & Shale	
4503	Lime	
4515	Chert	

S. L. M.

Board 4097.01
Strap 4095.71
Difference 1.30 short

RECEIVED
STATE CORPORATION COMMISSION
SEP 3 1970
CONSERVATION DIVISION
Wichita, Kansas

The undersigned, C. W. Sebitts, Attorney-in-Fact for PICKRELL DRILLING COMPANY, hereby certifies in behalf of said Company, that the above is a true and correct log of the formation encountered in drilling the above well as reflected by the Daily Drilling Reports.

PICKRELL DRILLING COMPANY
By C. W. Sebitts
Attorney-in-Fact

STATE OF KANSAS }
COUNTY OF SEDGWICK } ss.:

On this 18th day of September, 1968, before me the undersigned, a Notary Public, in and for

the County and State aforesaid, personally appeared C. W. Sebitts, to me known to be the identical person who subscribed the name of PICKRELL DRILLING COMPANY to the foregoing instrument as its Attorney-in-Fact and acknowledged to me that he executed the same as his free and voluntary act and deed, and as the free and voluntary act and deed of such company, for the uses and purposes therein set forth.

Given under my hand and seal of office the day and year last above written.

My commission expires: May 10, 1970

L. M. Whiting
Notary Public