

R


STATE OF KANSAS
STATE CORPORATION COMMISSION

Form CP-4

Give All Information Completely
Make Required Affidavit
Mail or Deliver Report to:
Conservation Division
State Corporation Commission
212 No. Market
Wichita, Kansas 67202

WELL PLUGGING RECORD

Hodgeman County, Sec. 25 Twp. 22 Rge. 22 (E) W (W)
Location as "NE/CNW/SW" or footage from lines 150' NW C SW NE
Lease Owner Pickrell Drlg. Co.
Lease Name Ruff 'B' Well No. #1
Office Address 705 Fourth Natl. Bank Bldg.; Wichita, Ks. 67202
Character of Well (completed as Oil, Gas or Dry Hole) Oil
Date well completed May 1 19 69
Application for plugging filed August 29 19 71
Application for plugging approved August 29 19 71
Plugging commenced September 8 19 71
Plugging completed September 11 19 71
Reason for abandonment of well or producing formation Dry Hole

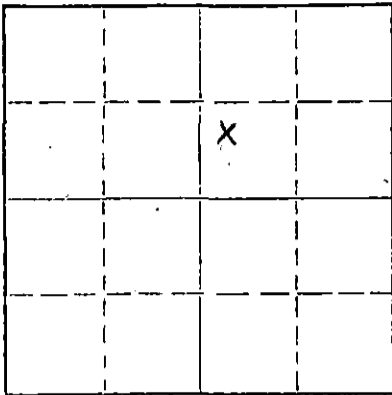

Locate well correctly on above
Section Plat

If a producing well is abandoned, date of last production August 20 19 71
Was permission obtained from the Conservation Division or its agents before plugging was commenced? Yes

Name of Conservation Agent who supervised plugging of this well Edgar Eves
Producing formation Mississippian Depth to top Bottom Total Depth of Well 4530 Feet
Show depth and thickness of all water, oil and gas formations.

OIL, GAS OR WATER RECORDS

CASING RECORD

FORMATION	CONTENT	FROM	TO	SIZE	PUT IN	PULLED OUT
	RECEIVED STATE CORPORATION COMMISSION OCT 14 1971 CONSERVATION DIVISION Wichita, Kansas			8 5/8	277	None
				5 1/2	4527	2917

Describe in detail the manner in which the well was plugged, indicating where the mud fluid was placed and the method or methods used in introducing it into the hole. If cement or other plugs were used, state the character of same and depth placed, from feet to feet for each plug set.

September 8, 1971 Plugged off bottom. Dumped sand to 4500'. Mixed and dumped 5 sx of cement.
September 11, 1971 Plugged off top. Globe Oil Well Cementing Co. mixed and pumped down 8 5/8" surface casing 10 sx of gel, 80 sx of cement, 7 sx of gel, 30 sx of cement, 3 sx of gel and 10 sx of cement.

(If additional description is necessary, use BACK of this sheet)

Name of Plugging Contractor RUSS CASING PULLING, INC.
Address P. O. Box 1082 Great Bend, Kansas 67530

STATE OF Kansas, COUNTY OF Sedgwick ss.
Carl W. Sebitts (employee of owner) or (owner or operator) of the above-described

well, being first duly sworn on oath, says: That I have knowledge of the facts, statements, and matters herein contained and the log of the above-described well as filed, and that the same are true and correct. So help me God.


(Signature)

C. W. Sebitts
705 Fourth Nat'l Bank Bldg.
Wichita, Kansas 67202

SUBSCRIBED AND SWORN to before me this 6th day of October, 19 71

Ruth M. Sullivan Notary Public.

My commission expires August 13, 1973

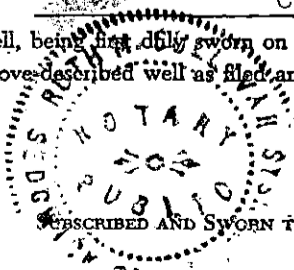

Copy handed
- WLB 5-7-69

15-083-20075-0000

ROTARY DRILLING LOG

COMPANY: Pickrell Drilling Company
705 4th National Bank Bldg.
Wichita, Kansas 67202
LOCATION: Ruff "B" No. 1,
150' NW of C SW NE Sec. 25-22S-22W
Hodgeman County, Kansas
CONTRACTOR: **PICKRELL DRILLING COMPANY**
Wichita, Kansas

Rotary Drilling Commenced 4/14/69
Rotary Drilling Completed 4/25/69

CASING RECORD: (15 jts.) 8 5/8" casing set at 277' KB and cemented with 165 sacks cement. Circulated. Completed 8:00 PM, April 14, 1969.

(142 jts.) 5 1/2" 14# casing set 4' off bottom @ 4527' (LTD).
Cemented with 125 Pozmix w/ 4% gel followed by 35 sacks common.
Completed 4:00 PM, April 26, 1969.

LOG

(Figures indicate bottom of formation — measurements from top of rotary bushing.)

40	Clay & Post Rock	C. F. S.
278	Shale & Shells	4320'
569	Shale & Red Bed	4345'
865	Red Bed & Shale	4530'
995	Sand	
1421	Shale & Sand Stringers	
1452	Anhydrite	
2095	Shale	
2185	Lime	Slope Tests
2625	Lime & Shale	2000
2768	Lime	2500
2950	Shale & Lime	3000
3116	Lime & Shale	3500
3530	Shale & Lime	4000
3560	Shale	4500
3870	Shale & Lime	
4055	Lime & Shale	
4125	Lime	
4265	Lime & Shale	
4315	Lime	S. L. M.
4530	Lime & Shale RTD	Board 3929.36
		Strap 3928.14
		Difference 1.22

RECEIVED
STATE CORPORATION COMMISSION
SEP 1 1971
CONSERVATION DIVISION
Wichita, Kansas

The undersigned, C. W. Sebitts, Attorney-in-Fact for PICKRELL DRILLING COMPANY, hereby certifies in behalf of said Company, that the above is a true and correct log of the formation encountered in drilling the above well as reflected by the Daily Drilling Reports.

PICKRELL DRILLING COMPANY
By [Signature]
C. W. Sebitts Attorney-in-Fact

STATE OF KANSAS }
COUNTY OF SEDGWICK } ss.:

On this 10 day of May, 19 69, before me the undersigned, a Notary Public, in and for the County of Sedgwick, State of Kansas, personally appeared C. W. Sebitts, to me known to be the Attorney-in-Fact of the PICKRELL DRILLING COMPANY who subscribed the name of PICKRELL DRILLING COMPANY to the foregoing instrument as its Attorney-in-Fact and acknowledged to me that he executed the same as his free and voluntary act and deed, and as the free and voluntary act and deed of such company, for the uses and purposes therein set forth.

Given under my hand and seal of office the day and year last above written.

My commission expires: May 10, 1970

[Signature]
L. M. Whiting Notary Public