


STATE OF KANSAS  
STATE CORPORATION COMMISSION

Give All Information Completely  
Make Required Affidavit  
Mail or Deliver Report to:  
Conservation Division  
State Corporation Commission  
211 No. Broadway  
Wichita, Kansas

WELL PLUGGING RECORD

NORTH

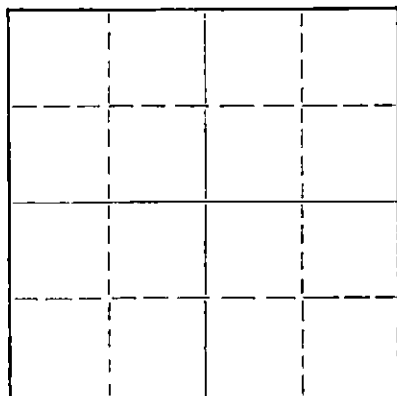

Locate well correctly on above  
Section Plat

Hodgeman County. Sec. 25 Twp. 22 Rge. 22W (E) (W)  
Location as "NE/CNWSW" or footage from lines NE SW  
Lease Owner Chief Drilling Co., Inc.  
Lease Name Mooney Well No. #1  
Office Address Suite 905 Century Plaza, Wichita, Kansas  
Character of Well (completed as Oil, Gas or Dry Hole) Dry hole  
Date well completed 6/7/70 19  
Application for plugging filed 6/7/70 19  
Application for plugging approved 6/7/70 19  
Plugging commenced 6/7/70 19  
Plugging completed 6/7/70 19  
Reason for abandonment of well or producing formation dry hole

If a producing well is abandoned, date of last production \_\_\_\_\_ 19\_\_\_\_  
Was permission obtained from the Conservation Division or its agents before plugging was commenced? Yes

Name of Conservation Agent who supervised plugging of this well Edgar J. Eves  
Producing formation \_\_\_\_\_ Depth to top \_\_\_\_\_ Bottom \_\_\_\_\_ Total Depth of Well 4518' Feet  
Show depth and thickness of all water, oil and gas formations.

OIL, GAS OR WATER RECORDS

CASING RECORD

FORMATION	CONTENT	FROM	TO	SIZE	PUT IN	PULLED OUT
		0	275'	8 5/8"		

Describe in detail the manner in which the well was plugged, indicating where the mud fluid was placed and the method or methods used in introducing it into the hole. If cement or other plugs were used, state the character of same and depth placed, from \_\_\_\_\_ feet to \_\_\_\_\_ feet for each plug set.

Plugged through drill pipe @ 850' w/80 sacks cement, 18 barrels mud  
Plugged through drill pipe @ 175' w/30 sacks cement  
Plugged through drill pipe @ 40' w/10 sacks cement

RECEIVED  
STATE CORPORATION COMMISSION  
JUN 9 1970  
CONSERVATION DIVISION  
Wichita, Kansas

(If additional description is necessary, use BACK of this sheet)  
Name of Plugging Contractor Chief Drilling Co., Inc.  
Address Suite 905 Century Plaza, Wichita, Kansas 67202

STATE OF KANSAS, COUNTY OF SEDGWICK, ss.  
Jim Robinson (employee of owner) or (owner or operator) of the above-described well, being first duly sworn on oath, says: That I have knowledge of the facts, statements, and matters herein contained and the log of the above-described well as filed and that the same are true and correct. So help me God.

(Signature) Jim Robinson  
Suite 905 Century Plaza, Wichita, Kansas  
(Address)



Subscribed and Sworn to before me this 8th day of June, 19 70

Karen E. Duarte  
Karen E. Duarte Notary Public.

Chief Drilling Co., Inc.

Mooney #1

C NE SW Sec. 25-22S-22W  
Hodgeman County, Kansas

Commenced: May 28, 1970

Completed: June 7, 1970

Rotary Drilling Contractor: Lauck Drilling Company, Incorporated.

Casing Record: 275' 8-5/8" Cemented with 165 sacks Cement.

Drillers Log

Clay Post Rock	45
Shale & Shells	525
Red Bed & Sand	770
Gypsum	780
Red Bed	855
Sand	1050
Shale	1075
Red Bed	1406
Anhydrite	1436
Shale & Shells	1700
Lime & Shale	2000
Lime	2785
Shale & Lime	2985
Lime & Shale	3875
Lime	3950
Lime & Shale	4020
Lime	4518 RTD

RECEIVED  
STATE CORPORATION COMMISSION  
JUN 19 1970  
CONSERVATION DIVISION  
Wichita, Kansas

STATE OF KANSAS, COUNTY OF SEDGWICK) ss:

I hereby certify that the above is a true and correct copy of the Driller's Log of the well drilled in the C NE SW of Section 25-22-22W, Hodgeman County, Kansas, to the best of my knowledge and belief.

CHIEF DRILLING CO., INC.

Jim Robinson  
Jim Robinson, Office Manager

Subscribed and sworn to before me this 18th day of June, 1970.

Karen E. Duarte  
Karen E. Duarte, Notary Public

