

STATE OF KANSAS
STATE CORPORATION COMMISSION


Form CP-4

Give All Information Completely
Make Required Affidavit
Mail or Deliver Report to:
Conservation Division
State Corporation Commission
212 No. Market
Wichita, Kansas 67202

WELL PLUGGING RECORD

Hodgeman County, Sec. 25 Twp. 22S Rge. 22 (W)

Location as "NE/CNW&SW¼" or footage from lines. Ctr NE NE
Lease Owner Champlin Petroleum Company
Lease Name Ruff Well No. 1
Office Address P. O. Box 308, Ellinwood, Kansas 67526
Character of Well (completed as Oil, Gas or Dry Hole) Dry Hole
Date well completed April 19, 19 66
Application for plugging filed September 28, 19 71
Application for plugging approved September 29, 19 71
Plugging commenced October 7, 19 71
Plugging completed October 7, 19 71
Reason for abandonment of well or producing formation

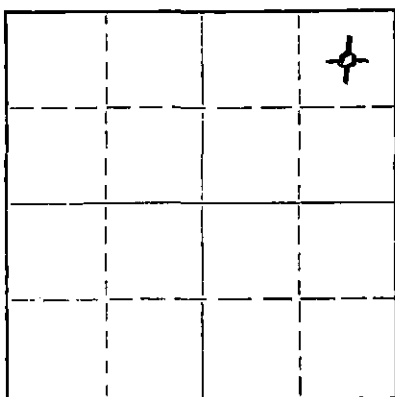

Locate well correctly on above Section Plat

If a producing well is abandoned, date of last production 19
Was permission obtained from the Conservation Division or its agents before plugging was commenced? Yes

Name of Conservation Agent who supervised plugging of this well E. Eves
Producing formation Depth to top Bottom Total Depth of Well 4495 Feet
Show depth and thickness of all water, oil and gas formations.

OIL, GAS OR WATER RECORDS

CASING RECORD

FORMATION	CONTENT	FROM	TO	SIZE	PUT IN	PULLED OUT
				8 5/8" OD	251'	None
				4 1/2" OD	4495'	None

Describe in detail the manner in which the well was plugged, indicating where the mud fluid was placed and the method or methods used in introducing it into the hole. If cement or other plugs were used, state the character of same and depth placed, from feet to feet for each plug set.

Pump 15 sacks of 50-50 pozmix followed by 5 sacks of Gel mud and fresh water and spotted cement on formation and pressured to 1200# then filled with mud to 941' and pumped in 15 sacks of 50-50 pozmix to 941' then filled with mud to 200' and pumped in 15 sacks of 50-50 Pozmix filling hole to surface.

Mr. Eves, State Plugger, was present during plugging.

Used Sun Oilwell Cementing Company to plug well.

10-13-71

RECEIVED
STATE CORPORATION COMMISSION
OCT 13 1971
CONSERVATION DIVISION
Wichita, Kansas

Name of Plugging Contractor Sun Oilwell Cementing Company
Address Great Bend, Kansas

STATE OF Kansas, COUNTY OF Barton, ss.
J. W. Meyers (employee of owner) or (owner or operator) of the above-described well, being first duly sworn on oath, says: That I have knowledge of the facts, statements, and matters herein contained and the log of the above described well as filed and that the same are true and correct. So help me God.

(Signature) J. W. Meyers, District Operations Manager
P. O. Box 308, Ellinwood, Kansas 67526
(Address)

Subscribed and sworn to before me this 11th day of October, 19 71

NOTARY PUBLIC
H. KENNETH STIVERS
BARTON CO. KANSAS
My commission expires 4/16/74

N. Kenneth Stivers Notary Public.

