


STATE OF KANSAS
STATE CORPORATION COMMISSION

Form CP-4

Give All Information Completely
Make Required Affidavit
Mail or Deliver Report to:
Conservation Division
State Corporation Commission
212 No. Market
Wichita, Kansas

WELL PLUGGING RECORD

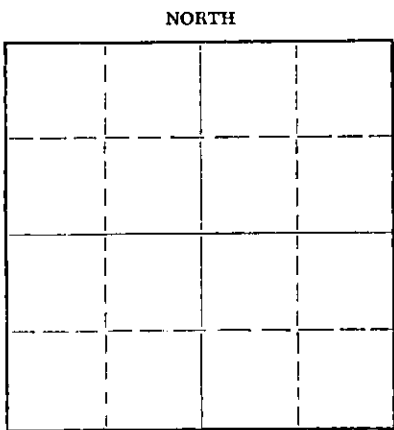

Locate well correctly on above
Section Plat.

Hodgeman County. Sec. 19 Twp. 22 Rge. (E) 23 (W)
Location as "NE/CNW/SW" or footage from lines. G NE NE
Lease Owner. Tilco, et al
Lease Name. Craighead Well No. 1
Office Address. 200 Sutton Place
Character of Well (completed as Oil, Gas or Dry Hole) Dry Hole
Date well completed 6-18 19 69
Application for plugging filed 6-18 19 69
Application for plugging approved 6-18 19 69
Plugging commenced 6-18 19 69
Plugging completed 6-18 19 69
Reason for abandonment of well or producing formation Dry Hole

If a producing well is abandoned, date of last production _____ 19____
Was permission obtained from the Conservation Division or its agents before plugging was commenced? Yes

Name of Conservation Agent who supervised plugging of this well Ed Eves
Producing formation _____ Depth to top _____ Bottom _____ Total Depth of Well 4650 Feet
Show depth and thickness of all water, oil and gas formations.

OIL, GAS OR WATER RECORDS

CASING RECORD

FORMATION	CONTENT	FROM	TD	SIZE	PUT IN	PULLED OUT
				8 5/8"	491	none

Describe in detail the manner in which the well was plugged, indicating where the mud fluid was placed and the method or methods used in introducing it into the hole. If cement or other plugs were used, state the character of same and depth placed, from _____ feet to _____ feet for each plug set.

Plugged with 80 sacks cement @ 200'
Plugged with 1/2 sack hulls 10 sack cement @ 40'
Plug Rat hole with 5 sacks

RECEIVED
STATE CORPORATION COMMISSION
JUL 3 1969
CONSERVATION DIVISION
Wichita, Kansas

(If additional description is necessary, use BACK of this sheet)
Name of Plugging Contractor Leben Drilling, Inc.
Address Box 486, Great Bend, Kansas

STATE OF KANSAS, COUNTY OF BARTON, ss.
Leslie Kite (employee of owner) or (owner or operator) of the above-described well, being first duly sworn on oath, says: That I have knowledge of the facts, statements, and matters herein contained and the log of the above-described well as filed and that the same are true and correct. So help me God.

(Signature) Leslie Kite

SUBSCRIBED AND SWORN TO before me this 1st day of July, 1969

My commission expires April 1, 1971
Ulanda Nichols Notary Public.

DRILLER'S LOG

COMPANY	Tilco, et al
CONTRACTOR	LEBEN DRILLING, INC.
FARM	CRAIGHEAD #1
LOCATION	G NE NE SECTION 19-22S-23W HODGEMAN COUNTY, KANSAS
COMMENCED	6-6-69
COMPLETED	6-18-69

0	45	Surface Clay, Sand
45	334	Shale, Sand
334	720	Shale
720	975	Red Bed
975	990	Anhydrite
990	1450	Red Bed Sand
1450	1593	Red Bed, Shale
1593	1624	Anhydrite
1624	2470	Shale, Shells
2470	3980	Lime, Shale
3980	4605	Lime
4605	4623	Chert
4623	4632	Lime, Chert
4632	4650	Chert
	<u>4650</u>	<u>RTD - D. & A.</u>

8 5/8" 20# new surface casing set @ 491' cemented with 325 sacks Common cement, 2% cc

I, Leslie Kite, do hereby certify that the above and foregoing is a true and correct copy of the log of the Craighead #1 Well, located G NE NE of Section 19, Township 22 South, Range 23 West, Hodgeman County, Kansas, as reflected by the records of Leben Drilling, Inc.

Leslie Kite

Leslie Kite

STATE OF KANSAS)
) SS
COUNTY OF BARTON)

Subscribed and sworn to and before me, a Notary Public, in and for Barton County, Kansas, this 1st day of July, 1969.

Ulanda Nichols

Ulanda Nichols

My Commission Expires:
April 1, 1971

RECEIVED
STATE CORPORATION COMMISSION
JUL 3 1969
CONSERVATION DIVISION
Wichita, Kansas