


WELL PLUGGING RECORD

Give All Information Completely  
Make Required Affidavit  
Mail or Deliver Report to:  
Conservation Division  
State Corporation Commission  
211 North Broadway  
Wichita, Kansas

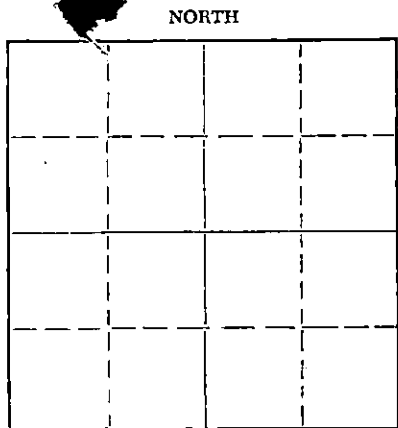

Locate well correctly on above  
Section Plat

Pawnee County, Sec. 29 Twp. 22S Rge. (E) 17(W)  
Location as "NE/CNW/SW" or footage from lines NE NE NE  
Lease Owner EARL F. WAKEFIELD  
Lease Name EWING Well No. I  
Office Address 515 UNION CENTER BUILDING, WICHITA, KANSAS  
Character of Well (completed as Oil, Gas or Dry Hole) DRY HOLE  
Date well completed November 5 19 60  
Application for plugging filed November 5 19 60  
Application for plugging approved November 5 19 60  
Plugging commenced November 5 19 60  
Plugging completed November 5 19 60  
Reason for abandonment of well or producing formation \_\_\_\_\_

If a producing well is abandoned, date of last production \_\_\_\_\_ 19 \_\_\_\_\_  
Was permission obtained from the Conservation Division or its agents before plugging was commenced? Yes

Name of Conservation Agent who supervised plugging of this well Frank Broadfoot  
Producing formation \_\_\_\_\_ Depth to top \_\_\_\_\_ Bottom \_\_\_\_\_ Total Depth of Well 4363 Feet  
Show depth and thickness of all water, oil and gas formations.

OIL, GAS OR WATER RECORDS

CASING RECORD

FORMATION	CONTENT	FROM	TO	SIZE	PUT IN	PULLED OUT
				8 5/8"	250'	NONE

Describe in detail the manner in which the well was plugged, indicating where the mud fluid was placed and the method or methods used in introducing it into the hole. If cement or other plugs were used, state the character of same and depth placed, from \_\_\_\_\_ feet to \_\_\_\_\_ feet for each plug set.

PLUGGED WITH DRILLING MUD 4363 to 240 SET 20 SX CEMENT PLUG,  
MUD TO 35' SET 10SX CEMENT

RECEIVED  
STATE CORPORATION COMMISSION  
NOV 14 1960  
CONSERVATION DIVISION  
Wichita, Kansas

(If additional description is necessary, use BACK of this sheet)  
Name of Plugging Contractor EARL F. WAKEFIELD  
Address 515 UNION CENTER BUILDING, WICHITA, KANSAS

STATE OF KANSAS, COUNTY OF SEDGWICK, ss.  
EARL F. WAKEFIELD (owner or operator) of the above-described well, being first duly sworn on oath, says: That I have knowledge of the facts, statements, and matters herein contained and the log of the above-described well as filed and that the same are true and correct. So help me God.

(Signature) Earl F. Wakefield  
515 Union Center Building, Wichita  
(Address)

SUBSCRIBED AND SWORN TO before me this 8th day of November, 1960

My commission expires July 26, 1962 C. A. Snow Notary Public.



WELL: E WING #1  
OPERATOR: EARL F. WAKEFIELD  
CONTRACTOR: EARL F. WAKEFIELD  
COMM: 10/23/60 COMP: 11/5/60

LOCATION: NE NE NE  
SECTION 29-22S-17W  
PAWNEE COUNTY, KANSAS  
CASING: 8 5/8" Set at 250'

Plug and Cement	250
Shale and Red Bed	1010
Shale and Lime Streaks	1135
Shale and Lime	1385
Shale	1885
Lime	2043
Lime and Shale	2175
Lime	2250
Lime and Shale Streaks	2535
Lime and Shale	2685
Shale and Lime	2825
Lime and Shale	2920
Shale and Sand	3050
Lime	3085
Shale and Lime	3185
Lime and Shale	3250
Shale and Lime	3380
Lime	3650
Lime and Shale	3671
Lime	3985
Lime and Shale	4065
Lime	4091
Conglomerate	4152
Lime- Chert	4182
Lime (Cherty)	4222
Chert	4250
Lime-Chert	4271
Lime	4346
Arbuckle	4363
T.D.	4363

**RECEIVED**  
STATE CONSERVATION COMMISSION  
NOV 14 1960  
CONSERVATION DIVISION  
Wichita, Kansas

STATE OF KANSAS )  
                          ) ss  
COUNTY OF SEDGWICK)

I Hereby certify that the above is a true and correct copy of the log on the EWING #1 well, located NE NE NE, SECTION 29-22S-17W, Pawnee County, Kansas.

EARL F. WAKEFIELD

By Earl F. Wakefield

Subscribed and sworn before me this 8th day of November, 1960

C. A. SNOW NOTARY PUBLIC

My Commission expires July 26, 1962.