

STATE OF KANSAS
STATE CORPORATION COMMISSION


WELL PLUGGING RECORD

Give All Information Completely
Make Required Affidavit
Mail or Deliver Report to:
Conservation Division
State Corporation Commission
800 Bittling Building
Wichita, Kansas

Pawnee County, Sec. 28 Twp. 22 Rge. 17 (E) W (W)

Location as "NE/CNW/SW" or footage from lines SW SW SE
Lease Owner Harms-Burt Drilling Co.
Lease Name Ewing Well No. 1
Office Address Box 184, Great Bend, Kansas
Character of Well (completed as Oil, Gas or Dry Hole) Dry Hole
Date well completed Aug. 15 19 55
Application for plugging filed Aug. 15 19 55
Application for plugging approved Aug. 15 (orally) 19 55
Plugging commenced Aug. 15 19 55
Plugging completed Aug. 15 19 55
Reason for abandonment of well or producing formation Dry Hole

NORTH

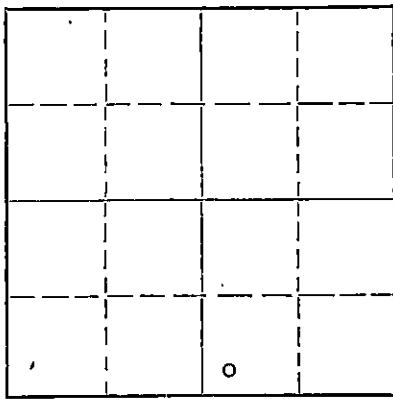

Locate well correctly on above
Section Plat

If a producing well is abandoned, date of last production 19
Was permission obtained from the Conservation Division or its agents before plugging was commenced? yes

Name of Conservation Agent who supervised plugging of this well Warren H. Horner, Box 207, Great Bend, Kansas
Producing formation _____ Depth to top _____ Bottom _____ Total Depth of Well 1178 Feet
Show depth and thickness of all water, oil and gas formations.

OIL, GAS OR WATER RECORDS

CASING RECORD

FORMATION	CONTENT	FROM	TO	SIZE	PUT IN	PULLED OUT
Surface		0	230	8 5/8"	230	none

Describe in detail the manner in which the well was plugged, indicating where the mud fluid was placed and the method or methods used in introducing it into the hole. If cement or other plugs were used, state the character of same and depth placed, from _____ feet to _____ feet for each plug set.

Filled hole from total depth to 225' with plug set at 225'
Put 20 sacks of cement on top of plug with mud up to 35'
and plug set at this point with 10 sacks of cement on top of plug.

(If additional description is necessary, use BACK of this sheet)

Name of Plugging Contractor Harms-Burt Drilling Co.
Address Box 184, Great Bend, Kansas

STATE OF Kansas, COUNTY OF Barton, ss.
Allan Harms (employee of owner) or (owner or operator) of the above-described well, being first duly sworn on oath, says: That I have knowledge of the facts, statements, and matters herein contained and the log of the above-described well as filed and that the same are true and correct. So help me God.

(Signature) Allan Harms
Box 184, Great Bend, Kansas
(Address)

SUBSCRIBED AND SWORN TO before me this 3 day of Sept., 19 55

My commission expires 1-26-58

Mary E Van Belt
RECEIVED
STATE CORPORATION COMMISSION
SEP - 6 1955
9-6-55
Notary Public.
Wichita, Kan.

PLUGGING
FILE SEC. 28 T22 R17W
194 18
BOOK PAGE 112

Driller's Log

Company: Harms-Burt Drilling Co.
 Farm: Ewing #1
 Commenced: August 3, 1955

SW SW SE Sec. 28-22-17W
 Pawnee County, Kansas
 Completed: Aug. 15, 1955

Elevation: 2050 RB.

*				
-	40	Sand & gravel	2570-2895	Shale & lime
40	- 165	Sand & clay	2895-3045	Lime & shale
165	- 515	Shale	3045-3130	Shale & lime
515	- 610	Sand	3130-3505	Lime & shale
610	-1030	Red bed & shells	3505-4045	Lime
1030	-1069	Red bed	4045-4075	Lime & shale
1069	-1091	Anhydrite	4075-4100	Lime & chert
1091	-1680	Shale & shells	4100-4118	Conglomerate
1680	-1800	Shale & salt	4118-4153	Chert
1800	-1930	Shale & shells	4153-4178	Lime & chert
1930	- 1965	Shale & lime	4178	Total depth
1965	- 2470	Lime		
2470	- 2570	Lime & shale		

Set 230' of 8 5/8" surface pipe, cemented with 250 sacks of common cement and 4 sacks of calcium chloride.

Tops:	Anhydrite	1069	Shaley Conglomerate	4071
	Heebner	3560	Viola	4160
	Brown Lime	3660		
	Lansing KC	3670		

Drill Stem Tests: #1 4063-4105 Open 30 min. shut in 30 min.
 Recovery 8' mud BHP 25#

#2 4114-4153 Open 1 1/2 hr. Shut in 30 min.
 Good blow throughout. Recovered 30' mud.
 IFP 20# FFP 30# BHP 260#

Ran Electric Log Halliburton

Dry, plugged and abandoned.

State of Kansas, County of Barton, SS:

Affidavit

I, Allan Harms, of Harms-Burt Drilling Co., being first duly sworn on oath state:

I have knowledge of the facts, statements, and matters herein contained and same are true and correct.

Signed

Allan Harms

Subscribed and sworn to before me this 3 day of Sept., 1955.

Mary E Van Pelt
 Notary Public

Comm. Exp. 1-20-58

RECEIVED
 STATE COMMISSION
 DETENTION DIVISION
 WICHITA, KANSAS
 1955

PLUGGING
 FILE SEC 28 T 22 R 17W
 BOOK PAGE 1111