


WELL PLUGGING RECORD

Give All Information Completely
Make Required Affidavit
Mail or Deliver Report to:
Conservation Division
State Corporation Commission
800 Biting Building
Wichita, Kansas

NORTH

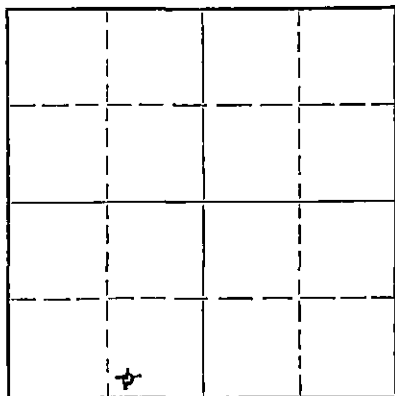

Locate well correctly on above
Section Plat

• Pawnee County, Sec. 26 Twp. 22 Rge. 17 (SW) (W) (W)
Location as "NE/CNW&SW" or footage from lines SW SE SW
Lease Owner Hilton Drilling Company, Inc.
Lease Name Zook Well No. 1
Office Address 2421 Tenth Street, Great Bend, Kansas
Character of Well (completed as Oil, Gas or Dry Hole) Dry Hole
Date well completed September 5, 19 55
Application for plugging filed September 6, 19 55
Application for plugging approved 19 _____
Plugging commenced September 6, 19 55
Plugging completed September 6, 19 55
Reason for abandonment of well or producing formation Dry

If a producing well is abandoned, date of last production _____ 19 _____
Was permission obtained from the Conservation Division or its agents before plugging was commenced? Yes

Name of Conservation Agent who supervised plugging of this well W. H. Horner
Producing formation _____ Depth to top _____ Bottom _____ Total Depth of Well 4329 Feet
Show depth and thickness of all water, oil and gas formations.

OIL, GAS OR WATER RECORDS

CASING RECORD

FORMATION	CONTENT	FROM	TO	SIZE	PUT IN	PULLED OUT
		0	215	8-5/8"	215	None

Describe in detail the manner in which the well was plugged, indicating where the mud fluid was placed and the method or methods used in introducing it into the hole. If cement or other plugs were used, state the character of same and depth placed, from _____ feet to _____ feet for each plug set.

Pumped in approximately 10 barrels of drilling mud,
Mixed 100 sacks of cement and pumped plug down at same.

(If additional description is necessary, use BACK of this sheet)
Name of Plugging Contractor Globe Oilwell Cementing, Inc.
Address Great Bend, Kansas

STATE OF KANSAS, COUNTY OF BARTON, ss.
Henry Peacock, Secretary (employee of owner) or (owner or operator) of the above-described well, being first duly sworn on oath, says: That I have knowledge of the facts, statements, and matters herein contained and the log of the above-described well as filed and that the same are true and correct. So help me God.

(Signature) Henry Peacock Secretary
Great Bend, Kansas
(Address)

SUBSCRIBED AND SWORN to before me this 6th day of September, 19 55

My commission expires January 26, 1959

Carmen Reinhardt Leiker
Carmen Reinhardt Leiker Notary Public.

24-7368-B 3-53-20M

RECEIVED
STATE CORPORATION COMMISSION

SEP - 7 1955

CONSERVATION DIVISION
Wichita, Kansas

9-7-55

PLUGGING
FILE SEC 26 T 22 R 17 W
BOOK PAGE 147 LINE 44

DRILLER'S LOG

COMPANY: HILTON DRILLING COMPANY, INC. LOCATION: SW SE SW
 Section 26-22S-17W
 CONTRACTOR: HILTON DRILLING COMPANY, INC. Pawnee County, Kansas
 FARM NAME: ZOOK NO. 1 ELEVATION: 2041 D.F.
 COMMENCED: August 22, 1955 Casing Used: 8-5/8" @ 215' with 200 sacks
 COMPLETED: September 5, 1955

Sand and Big Gravel	40
Sand	70
Shale and Sand	180
Shale	215
Shale and Shells	370
Red Bed and Sand	605
Red Bed	1070
Anhydrite	1100
Shale, Salt and Shells	1685
Shale and Lime	2480
Lime	2720
Shale and Lime	3240
Lime	3576
Shale and Lime	3677
Lime	3955
Shale and Lime	4114
Shale, Lime and Chert	4144
Shale and Chert	4186
Lime and Chert	4254
Shale and Lime	4283
Shale and Sand	4308
Lime	4329
Total Depth	4329

STATE OF KANSAS)
) SS
 COUNTY OF BARTON)

I, the undersigned, being duly sworn on oath, state that the above statement and log are true and a correct record and log of the well drilled at the location above described.

HILTON DRILLING COMPANY, INC.

Henry Peacock
 Henry Peacock, Secretary

Subscribed and sworn to before me this 6th day of September, 1955.

My commission expires January 26, 1959

Carmen Reinhardt Leiker
 Carmen Reinhardt Leiker, Notary Public

RECEIVED
 STATE CORPORATION COMMISSION

SEP - 7 1955

REGISTRATION DIVISION

PLUGGING
 FILE SEC 26-22S-17W
 BOOK PAGE 142 LINE 74