


STATE OF KANSAS
STATE CORPORATION COMMISSION

WELL PLUGGING RECORD

Give All Information Completely
Make Required Affidavit
Mail or Deliver Report to:
Conservation Division
State Corporation Commission
211 No. Broadway
Wichita, Kansas

Pawnee County. Sec. 25 Twp. 22 Rge. 17 (E) (W)
Location as "NE/CNW/SW" or footage from lines NW NW NE

Lease Owner Real Petroleum Company
Lease Name F. D. Lowrey Well No. 1-V
Office Address 6810 West Kellog Wichita, Kansas
Character of Well (completed as Oil, Gas or Dry Hole) _____
Date well completed _____ 19____
Application for plugging filed _____ 19____
Application for plugging approved _____ 19____
Plugging commenced 7-10-70 _____ 19____
Plugging completed 7-16-70 _____ 19____
Reason for abandonment of well or producing formation _____

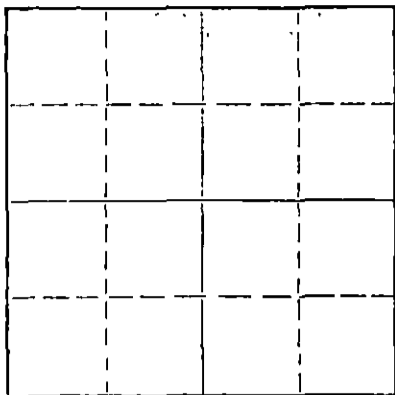

Locate well correctly on above
Section Plat

If a producing well is abandoned, date of last production _____ 19____
Was permission obtained from the Conservation Division or its agents before plugging was commenced? Yes

Name of Conservation Agent who supervised plugging of this well Leo Massey
Producing formation _____ Depth to top _____ Bottom _____ Total Depth of Well 4257 Feet
Show depth and thickness of all water, oil and gas formations.

OIL, GAS OR WATER RECORDS

CASING RECORD

FORMATION	CONTENT	FROM	TO	SIZE	PUT IN	PULLED OUT
				10 3/4	840	None
				5 1/2	4255	2914.31

STATE CORPORATION COMMISSION
RECEIVED
JUL 23 1970
CONSERVATION DIVISION
Wichita, Kansas

Describe in detail the manner in which the well was plugged, indicating where the mud fluid was placed and the method or methods used in introducing it into the hole. If cement or other plugs were used, state the character of same and depth placed, from _____ feet to _____ feet for each plug set.

Moved unit to location.
Broke off the tubinghead. Levelled up around cellar. Set in unit. Raised pole, drove stakes and made up bailer to check hole. Pushed a plug to 3500', dumped 10 gallons of sand and dumped 5 sacks of cement on bottom. Cleaned out cellar. Did not unpack head since water flowing out of surface pipe.
Unpacked head. Set in sills, jacks and spiders. Got slips out of head. Took tension on pipe and had 23" at 2500 psi. on gauge. Shot pipe off at 3192' but it was still in cement. Shot pipe off at 3124' and worked pipe to 26" stretch. Pipe moved approximately 10 inches. Left on tension over night.
Worked pipe, but it was still not loose. Rigged up to shoot. Shot pipe at 3004'.
Worked pipe, it was still not loose. Shot pipe at 2902' and lost 2500' of wire in hole. Rigged up spear and fished out wire.
Put on new measuring line. Worked pipe loose and started laying down pipe. Had wet string of pipe with every joint full of water and last 10 joints were full of mud. Laid down 90 joints of 5 1/2" casing.
Loaded trailer and cleared hole for plugging. Bailed water out of cellar and took off braden head. Laid down pole and loaded unit. Tallied pipe and Halliburton squeezed down the 10 3/4" with 5 sacks of hulls, 30 sacks of gel and 140 sacks of pozmix cement with 6% additional gel. Moved off location.


(If additional description is necessary, use BACK of this sheet)

Name of Plugging Contractor Forbes Casing Pulling Company, Inc.
Address P. O. Box 221 Great Bend, Kansas 67530

STATE OF Kansas, COUNTY OF Barton, ss.
James W. Rockhold (employee of owner) or (owner or operator) of the above-described well, being first duly sworn on oath, says: That I have knowledge of the facts, statements, and matters herein contained and the log of the above-described well as filed and that the same are true and correct. So help me God.

(Signature) James W. Rockhold
P. O. Box 221 Great Bend, Kansas
(Address)

Subscribed AND SWORN TO before me this 21 day of July, 19 70

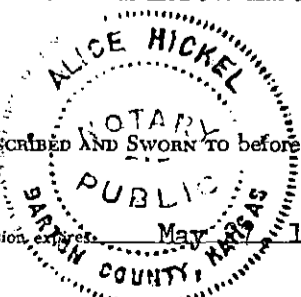

My commission expires May 1973

Alice Nickel
Notary Public.