

STATE OF KANSAS  
STATE CORPORATION COMMISSION


WELL PLUGGING RECORD

Give All Information Completely  
Make Required Affidavit  
Map or Diver Report to:  
Conservation Division  
State Corporation Commission  
800 Bitting Building  
Wichita, Kansas

OR  
FORMATION PLUGGING RECORD

Strike out upper line  
when reporting plug-  
ging of formations.

NORTH

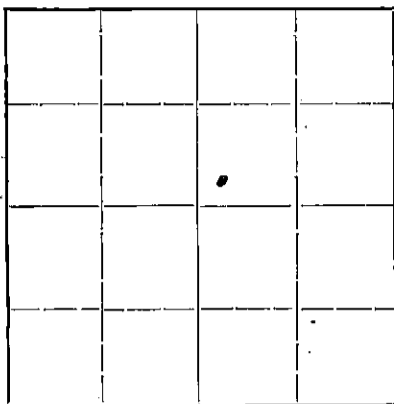

Locate well correctly on above  
Section Plat

Harvey County. Sec. 23 Twp. 22S Rge. 3 (E) 3 (W)  
Location as "NE 1/4 NW 1/4 SW 1/4" or footage from lines SW SW NE/4  
Lease Owner Atlantic Oil Corporation,  
Lease Name Randall Well No. 1  
Office Address Kennedy Building, Tulsa, Okla.  
Character of Well (completed as Oil, Gas or Dry Hole) Dry hole  
Date, well completed 8 - 19 - 19 43  
Application for plugging filed 8 - 24 - 19 43  
Application for plugging approved BY Ruel Durkee 8 - 19 - 19 43  
Plugging Commenced 8 - 19 - 19 43  
Plugging Completed 8 - 19 - 19 43  
Reason for abandonment of well or producing formation Dry hole

If a producing well is abandoned, date of last production 19  
Was permission obtained from the Conservation Division or its agents before plugging was com-  
menced? Yes.

Name of Conservation Agent who supervised plugging of this well Ruel Durkee  
Producing formation Depth to top Bottom Total Depth of Well 3860 Feet  
Show depth and thickness of all water, oil and gas formations.

OIL, GAS OR WATER RECORDS

CASING RECORD

Formation	Content	From	To	Size	Put In	Pulled Out
Chat	Dry	3242		10 3/4	196	None
Viola Lime	Dry	3660				

Describe in detail the manner in which the well was plugged, indicating where the mud fluid was placed and the method or methods used in introducing it into the hole. If cement or other plugs were used, state the character of same and depth placed, from feet to feet for each plug set.

Filled hole from total depth of 3860 to 190 ft. with heavy rotary mud. Dumped 20 sacks of cement on bridge at 190 ft. Filled hole with mud and dumped 5 sacks of cement in top of surface pipe.

8-27-43

PLUGGING  
FILE 23 22 3W  
BOOK 88 19

(If additional description is necessary, use BACK of this sheet)

Correspondence regarding this well should be addressed to Atlantic Oil Corporation  
Address Kennedy Building, Tulsa, Oklahoma.

STATE OF Kansas COUNTY OF Harvey  
G. J. Bryant (Employer of owner or owner or operator of the above-described well,

being first duly sworn on oath, says: That I have knowledge of the facts, statements, and matters herein contained and the log of the above-described well as filed and that the same are true and correct. So help me God.

(Signature) G. J. Bryant

SUBSCRIBED AND SWORN to before me this 25th day of August, 1943

My commission expires July 22, 1944 Notary Public.

Atlantic Oil Corporation  
 Randall # 1  
 SW SW NE/4 Sec. 23-22S-3W  
 Harvey County, Kansas

COMMENCED 7-4-43  
 COMPLETED 8-20-43

0  
 70 Sand  
 190 Sand & shale  
 400 Shale  
 910 Lime & shale  
 938 Stickey shale  
 1605 Lime & shale  
 1625 Lime  
 1900 Lime & shale  
 2030 Lime  
 2184 Lime & shale  
 2330 Shale  
 2519 Lime & shale  
 2585 Lime  
 2650 K.C. Lime  
 2745 Lime & shale  
 3065 Lime  
 3075 Shale  
 3130 Shale & lime  
 3153 Shale  
 3210 Lime  
 3242 Chat & chert  
 3277 Lime  
 3304 Chert  
 3312 Chat & chert  
 3320 Chat  
 3343 Chert  
 3373 Chert & chat  
 3378 " "  
 3380 Chert  
 3396 Lime  
 3403 Lime & chert  
 3423 Lime  
 3424 Chert, rough  
 3444 Shale  
 3464 Lime & chert  
 3471 Lime Broken  
 3499 Lime & shale  
 3551 Lime

3558 Dolomite  
 3573 Lime & chert  
 3575 Dolomite  
 3599 Lime  
 3613 Shale  
 Twisted off drill pipe  
 Set Whipstock  
 3632 Shale  
 3653 Lime & shale  
 3660 Lime & chert  
 3663 Lime, Viola  
 3707 Lime & sand  
 3725 Shale & sand  
 3732 Lime, hard  
 3740 Shale & hard sand  
 3748 Lime  
 3773 Shale & sand  
 3785 Shale  
 3805 Lime  
 3848 Lime & chert  
 3860 Lime, TOTAL DEPTH

**PLUGGING**  
 FILE REC 23 22 3W  
 BOOK PAGE 28 LINE 19

Subscribed and sworn to be fore  
 me this 25<sup>th</sup> day of August, 1943

*A. L. Deidrebeck*  
 Notary Public

My Commission Expires July 22, 1944

I hereby certify that the above  
 is a true and correct copy of the log  
 of Atlantic-Randall # 1, SW SW NE/4,  
 Sec. 23-22S-3W, Harvey County, Kansas

*G. J. Bryan*  
 AUG 27 1943  
 HARVEY COUNTY, KANSAS