

STATE OF KANSAS
STATE CORPORATION COMMISSION

Form CP-4


Give All Information Completely
Make Required Affidavit
Mail or Deliver Report to:
Conservation Division
State Corporation Commission
212 West Market
Wichita, Kansas

WELL PLUGGING RECORD

Hodgeman County, Sec. 20 Twp. 22 Rge. (E) 22 (W)

Location as "NE/CNW/SW" or footage from lines NW SE
Lease Owner Sun Oil Company
Lease Name Bamberger Well No. 10
Office Address 800 Security Life Bldg.
Character of Well (completed as Oil, Gas or Dry Hole) Oil
Date well completed 6-25 19 63
Application for plugging filed 12-12 19 73
Application for plugging approved 12-14 19 73
Plugging commenced 8-21 19 74
Plugging completed 9-5 19 74
Reason for abandonment of well or producing formation Depleted

NORTH

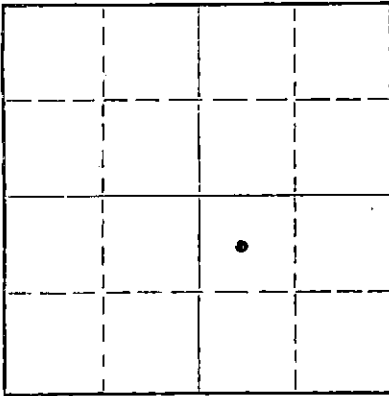

Locate well correctly on above
Section Plat

If a producing well is abandoned, date of last production 19
Was permission obtained from the Conservation Division or its agents before plugging was commenced? Yes

Name of Conservation Agent who supervised plugging of this well Edgar Eves
Producing formation Mississippi Depth to top 4498 Bottom 4503 Total Depth of Well 4503 Feet
Show depth and thickness of all water, oil and gas formations.

OIL, GAS OR WATER RECORDS

CASING RECORD

FORMATION	CONTENT	FROM	TO	SIZE	PUT IN	PULLED OUT
				8 5/8	258	-
				5 1/2	4498	2425

Describe in detail the manner in which the well was plugged, indicating where the mud fluid was placed and the method or methods used in introducing it into the hole. If cement or other plugs were used, state the character of same and depth placed, from _____ feet to _____ feet for each plug set.

Set plug at 4483; plugged back with sand to 4448 and dumped 4 sx cement with dump bailer.
Shot casing at 2754 and 2425. Pulled and layed down 2425 ft. of 5 1/2" casing.
Plugged with 80 sx cement, 14 sx gel, 30 sx cement, 8 sx gel, and 10 sx cement.
Plug at surface.

RECEIVED
STATE CORPORATION COMMISSION

SEP 30 1974

CONSERVATION DIVISION
Wichita, Kansas

Name of Plugging Contractor Charlie Crow Drilling Co. (If additional description is necessary, use BACK of this sheet)
Address Box 706, Hays, Kansas

STATE OF COLORADO, COUNTY OF DENVER, ss.
D. A. Coppedge (employee of owner) or (owner or operator) of the above-described well, being first duly sworn on oath, says: That I have knowledge of the facts, statements, and matters herein contained and the log of the above-described well as filed and that the same are true and correct. So help me God.

(Signature) *D. A. Coppedge*
800 Security Life Bldg., Denver, Co. 80202
(Address)

SUBSCRIBED AND SWORN TO before me this 25th day of September, 1974

My commission expires Nov. 22, 1974

Mary Marson
Notary Public.

15-083-10303-0000

Sunray DX Oil Company
Tulsa, Oklahoma

Tulsa, Oklahoma
June 28, 1963

Contractor: Stickle Drilling Company
Date Commenced: June 17, 1963
Date Completed: June 25, 1963

Bamberger No. 10
NW SE Sec. 20-22S-22W
Hodgeman County, Kans.

DRILLER'S LOG

Depth Figures Indicate Base of Formation:

Clay and shale	40
Shale	259
Shale and red bed	915
Sand	1070
Shale	2518
Lime and shale	2672
Shale and lime	2839
Lime and shale	3272
Shale and lime	3425
Lime and shale	4211
Lime	4503 TD

RECEIVED
STATE CORPORATION COMMISSION
DEC 14 1973
CONSERVATION DIVISION
Wichita, Kansas

I, Fred E. Stickle, hereby certify the above to be a true and complete Driller's Log for Sunray DX Oil Company's Bamberger No. 10 Well, NW SE Section 20-22S-22W, Hodgeman County, Kansas.

Fred E. Stickle
FRED E. STICKLE

M. Wensley
Notary Public

My Commission Expires January 11, 1967