


STATE OF KANSAS  
STATE CORPORATION COMMISSION

Form CP-4

WELL PLUGGING RECORD

Give All Information Completely  
Make Required Affidavit  
Mail or Deliver Report to:  
Conservation Division  
State Corporation Commission  
212 No. Market  
Wichita, Kansas

NORTH

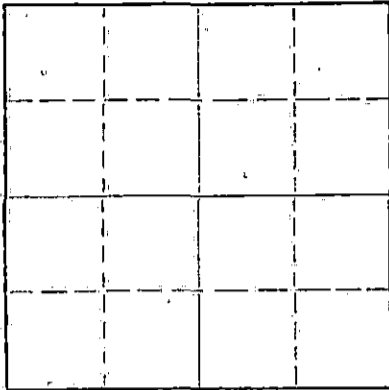

Locate well correctly on above  
Section Plat

Stafford County. Sec. 7 Twp. 22S Rge. (X) 13(W)  
Location as "NE/CNW/SW" or footage from lines Approx. SW SE SW  
Lease Owner John C. Graves, et al  
Lease Name Wright Well No. 1  
Office Address 412 Union Center, Wichita, Kansas  
Character of Well (completed as Oil, Gas or Dry Hole) Dry Hole  
Date well completed September 14, 19 66  
Application for plugging filed September 14, 19 66  
Application for plugging approved September 14, 19 66  
Plugging commenced September 14, 19 66  
Plugging completed September 14, 19 66  
Reason for abandonment of well or producing formation

If a producing well is abandoned, date of last production 19  
Was permission obtained from the Conservation Division or its agents before plugging was commenced? Yes

Name of Conservation Agent who supervised plugging of this well Herman Justus, Nickerson, Kansas  
Producing formation Depth to top Bottom Total Depth of Well 3850 Feet  
Show depth and thickness of all water, oil and gas formations.

OIL, GAS OR WATER RECORDS

CASING RECORD

FORMATION	CONTENT	FROM	TO	SIZE	PUT IN	PULLED OUT
				8-5/8"	277'	None

Describe in detail the manner in which the well was plugged, indicating where the mud fluid was placed and the method or methods used in introducing it into the hole. If cement or other plugs were used, state the character of same and depth placed, from feet to feet for each plug set.

Mudded up with heavy mud to 240 feet. Followed by wooden plug and 1/4 sack hulls. Placed 25 sacks cement onto hulls. Mudded up with heavy mud to 40 feet followed by wooden plug, 1/4 sack hulls and 10 sacks cement to base of well cellar. Plugged rat hole with 2 sacks cement.

RECEIVED  
STATE CORPORATION COMMISSION  
SEP 28 1966  
CONSERVATION DIVISION  
WICHITA, KANSAS  
9-28-66

(If additional description is necessary, use BACK of this sheet)  
Name of Plugging Contractor Graves Drilling Co., Inc.  
Address 412 Union Center, Wichita, Kansas

STATE OF KANSAS, COUNTY OF BUTLER, ss.  
John C. Graves (employee of owner) or (owner or operator) of the above-described

well, being first duly sworn on oath, says: That I have knowledge of the facts, statements, and matters herein contained and the log of the above-described well as filed and that the same are true and correct. So help me God.

(Signature) John C. Graves  
412 Union Center, Wichita, Kansas 67202  
(Address)

SUBSCRIBED AND SWORN to before me this 19th day of September, 19 66

My commission expires April 30, 1967  
Betty Brandt Notary Public

ROTARY DRILLERS' LOG

OPERATOR: John C. Graves, et al DRILLING COMMENCED: September 8, 1966  
 412 Union Center  
 Wichita, Kansas

CONTRACTOR: Graves Drilling Co., Inc. DRILLING COMPLETED: September 14, 1966  
 412 Union Center  
 Wichita, Kansas

CASING RECORD: 10 Jts. 277' 8-5/8" LOCATION: Wright No. 1  
 cemented with 275 sacks Approx. SW SE SW  
 Section 7-22S-13W  
 Stafford County, Kansas

0 - 285 Sand, shale & lime  
 285 - 767 Red bed  
 767 - 813 Anhydrite  
 813 - 1585 Shale & shells  
 1585 - 1755 Shale & lime  
 1755 - 2030 Lime & shale  
 2030 - 2765 Shale & lime  
 2765 - 3002 Lime & shale  
 3002 - 3173 Shale & lime  
 3173 - 3298 Lime  
 3298 - 3318 Shale & lime  
 3318 - 3789 Lime  
 3789 - 3805 Shale & sandy shale  
 3805 - 3845 Sandy shale  
 3845 - 3850 Lime  
 3850 Rotary Total Depth

RECEIVED  
 STATE CORPORATION COMMISSION  
 SEP 28 1966  
 CONSERVATION DIVISION  
 WICHITA, KANSAS

I hereby certify the foregoing statements to be true and correct to the best of my knowledge.

GRAVES DRILLING CO., INC.

By John C. Graves  
President

STATE OF KANSAS )  
                          ) SS:  
BUTLER COUNTY )

Subscribed and sworn to before me, a Notary Public, this 19th of September, 1966.

My commission expires: April 30, 1967

Betty Brandt  
Betty Brandt Notary Public