


STATE OF KANSAS
STATE CORPORATION COMMISSION

Give All Information Completely
Make Required Affidavit
Mail or Deliver Report to:
Conservation Division,
State Corporation Commission
P. O. Box 17027
Wichita, Kansas 67217
NORTH

WELL PLUGGING RECORD

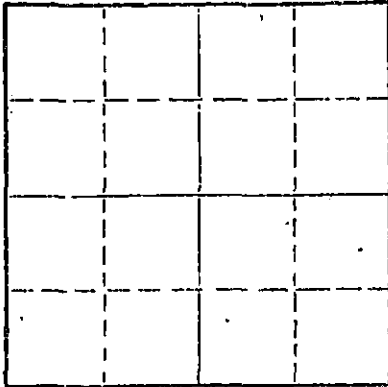

Locate well correctly on above
Section Plot

Stafford County, Sec. 36 Twp. 22 Rge. 14 (E) (W) X
Location as "NE/CNW/SW" or footage from lines: C E/2 NE NW
Lease Owner: Graves Drilling Co., Inc.
Lease Name: Bartlett Well No. #2
Office Address: 505 Union Center Bldg. Wichita, Kansas 675202
Character of Well (completed as Oil, Gas or Dry Hole)
Date well completed: 19
Application for plugging filed: 19
Application for plugging approved: 19
Plugging commenced: 2-16-74 19
Plugging completed: 2-21-74 19
Reason for abandonment of well or producing formation:

If a producing well is abandoned, date of last production: 19
Was permission obtained from the Conservation Division or its agents before plugging was commenced?

Name of Conservation Agent who supervised plugging of this well: G. R. Biberstein
Producing formation: Depth to top: Bottom: Total Depth of Well 3860' Feet
Show depth and thickness of all water, oil and gas formations.

OIL, GAS OR WATER RECORDS

CASING RECORD

FORMATION	CONTENT	FROM	TO	SIZE	PUT IN	PULLED OUT
				5 1/2"	3669'	2913.27'
				8 5/8"	262'	

Describe in detail the manner in which the well was plugged, indicating where the mud fluid was placed and the method or methods used in introducing it into the hole. If cement or other plugs were used, state the character of same and depth placed, from feet to feet for each plug set.

Made bottom hole plug back with sand to 3575'. Mixed and ran 5 sacks cement thru dump bailer.
Plugged hole with 2 sacks hulls - 20 sacks gel and 100 sacks cement.


RECEIVED
STATE CORPORATION COMMISSION
FEB 25 1974
CONSERVATION DIVISION
Wichita, Kansas

(If additional description is necessary, use BACK of this sheet)
Name of Plugging Contractor: Southwest Casing Pulling Co.
Address: Box 364 Great Bend, Kansas

STATE OF Kansas, COUNTY OF Barton ss.
Southwest Casing Pulling Co. (employee of owner) or (owner or operator) of the above-described well, being first duly sworn on oath, says: That I have knowledge of the facts, statements, and matters herein contained and the log of the above-described well as filed and that the same are true and correct. So help me God.

(Signature) W. C. Spencer Sec
Box 364 Great Bend, Kansas
(Address)

Subscribed and sworn to before me this 22 day of February, 1974.
Erving D. Miller
Notary Public.

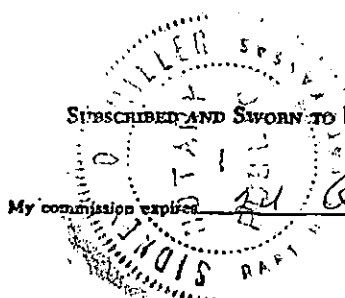

ROTARY DRILLERS' LOG

OPERATOR: John C. Graves, et al DRILLING COMMENCED: June 17, 1965
 412 Union Center
 Wichita, Kansas

CONTRACTOR: Graves Drilling Co., Inc. DRILLING COMPLETED: June 25, 1965
 412 Union Center
 Wichita, Kansas

CASING RECORD: 8 Jts. 262' 8-5/8" LOCATION: Bartlett No. 2
 cemented with 300 sacks. C E/2 NE NW
 Section 36-22S-14W
 117 Jts. 3669' 5 1/2" Stafford County, Kansas
 cemented with 150 sacks.

0 - 258 Sand & shale
 258 - 285 Shale & red bed
 285 - 390 Sand
 390 - 840 Red bed & shale
 840 - 862 Anhydrite
 862 - 1628 Shale & shells
 1628 - 1820 Lime & shale
 1820 - 2010 Lime
 2010 - 3455 Lime & shale
 3455 - 3471 Brown lime & shale
 3471 - 3605 Lime
 3605 - 3640 Lime & shale
 3640 - 3692 Lime
 3692 - 3754 Lime & shale
 3754 - 3799 Cherty lime
 3799 - 3840 Lime, shale & sand
 3840 - 3860 Lime
 3860 Rotary Total Depth

RECEIVED
 STATE CORPORATION COMMISSION
 NOV 15 1973
 CONSERVATION DIVISION
 Wichita, Kansas

I hereby certify the foregoing statements to be true and correct to the best of my knowledge.

GRAVES DRILLING CO., INC.

By John C. Graves
 President

STATE OF KANSAS)
) SS:
 COUNTY OF BUTLER)

Subscribed and sworn to before me, a Notary Public, this 12th day of July, 1965.

Betty Brandt
 Betty Brandt Notary Public

My commission expires: April 30, 1967.