

STATE OF KANSAS
STATE CORPORATION COMMISSION

WELL PLUGGING RECORD

Give All Information Completely
Make Required Affidavit
Mail or Deliver Report to:
Conservation Division
State Corporation Commission
300 Bitting Building
Wichita, Kansas


OR

Strike out upper line
when reporting plugging
off formations.

~~WELL PLUGGING RECORD~~

Stafford County. Sec. 36 Twp. 22 Rge. (E) 14 (W)

Location as "NE $\frac{1}{4}$ NW $\frac{1}{4}$ SW $\frac{1}{4}$ " or footage from lines C. SE. SE. NW
Lease Owner Sinclair Oil & Gas Co.
Lease Name Shirley Beaver Well No. 1
Office Address Box 521, Tulsa, Okla.
Character of Well (completed as Oil, Gas or Dry Hole) Oilwell
Date well completed October 4 1949
Application for plugging filed March 14 1951
Application for plugging approved March 16 1951
Plugging commenced March 19 1951
Plugging completed March 23 1951
Reason for abandonment of well or producing formation Production depleted

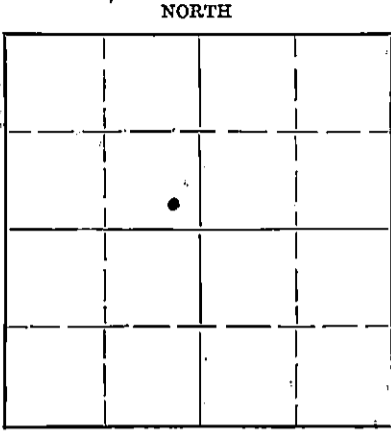

Locate well correctly on above
Section Plat

If a producing well is abandoned, date of last production March 15 1951
Was permission obtained from the Conservation Division or its agents before plugging was commenced? YES

Name of Conservation Agent who supervised plugging of this well C.D. Stough
Producing formation Arbuckle Lime Depth to top 3829 Bottom 3906 Total Depth of Well 3906 Feet
Show depth and thickness of all water, oil and gas formations.

OIL, GAS OR WATER RECORDS

CASING RECORD

Formation	Content	From	To	Size	Put In	Pulled Out
Arbuckle Lime	dry	3829	3906	8-5/8"	444'	0
				5-1/2"		2859'

Describe in detail the manner in which the well was plugged, indicating where the mud fluid was placed and the method or methods used in introducing it into the hole. If cement or other plugs were used, state the character of same and depth placed, from _____ feet to _____ feet for each plug set.

- 3906-3875 cement
- 3875-3820 Sand
- 3820- 250 heavy mud
- 250- 240 rock bridge
- 240- 195 cement 15 sx
- 195- 35 rock
- 35- 0 cement 10sx

3-29-51

RECEIVED
STATE CORPORATION COMMISSION
MAR 29 1951
CONSERVATION DIVISION
Wichita, Kansas

(If additional description is necessary, use BACK of this sheet)

Correspondence regarding this well should be addressed to Mr. E.H. Gibbons
Address Box 551 Chase, Kas

STATE OF Kansas, COUNTY OF Rice, ss.

L. E.H. Gibbons (employee of owner) or (owner) of the above-described well,
being first duly sworn on oath, says: That I have knowledge of the facts, statements, and matters herein contained and the log of the above-described well as filed and that the same are true and correct. So help me God.

(Signature) E.H. Gibbons

Box 551 Chase, Kas (Address)

SUBSCRIBED AND SWORN to before me this 27th day of March, 19 51

My commission expires Aug 22 1953

B.J. Ritterhouse
Notary Public.

PLUGGING
FILE SEC 36 T 22 R 14
BOOK PAGE 67 LINE 22

Well Log
Sinclair Oil & Gas Company


COPY, 3-14-1951

Shirley Beaver #1
NW/4, 36-22S-14W, Stafford Co., Kas
330' fm South & East lines
Elev. 1931 rig flr.

Harbar Drilling Co., Contr.
Began drlg 9-22-1949
Comp. drlg 10-4-1949
TD 3906' in Arbuckle lime
Perforated 22 holes 3831-34'
Initial potential 377 oil, no wtr
after acid.

Drillers Log
Surface Level Measurements

Sand-Clay	450'
8-5/8" csg set @ 449' w/250 sx cmt	
Red Bed	835
Anhydrite	860
Shale & Shells	900
Shale-Salt-Red Bed	1144
Shale-Shells	1714
Lime & Shale	1844
Lime-Ft Riley	1929
Shale & Lime	2164
Lime & Shale	2399
Shale & Lime	2604
Shale	2769
Shale & Lime	2899
Lime & Shale	2994
Shale & Lime	3164
Lime & Shale	3384
Shale & Lime	3471
Lime & Shale	3631
Lime	3764
Cherty Lime & Shale	3789
Lime & Chert	3929-TD drld.
Plugged back to	3906' Completed TD.
5 1/2" csg set @ 3928' w/175 sx cmt	
Top Kas City	3457
Conglomerate	3749
Viola	3758
Simpson	3783
Arbuckle	3829

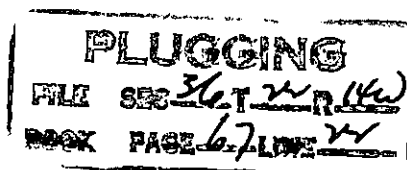

RECEIVED
STATE CORPORATION COMMISSION

MAR 1 6 1951
CONSERVATION DIVISION
Wichita, Kansas