


STATE OF KANSAS  
STATE CORPORATION COMMISSION

Form CP-4

Give All Information Completely  
Make Required Affidavit  
Mail or Deliver Report to:  
Conservation Division  
State Corporation Commission  
212 No. Market  
Wichita, Kansas

WELL PLUGGING RECORD

NORTH

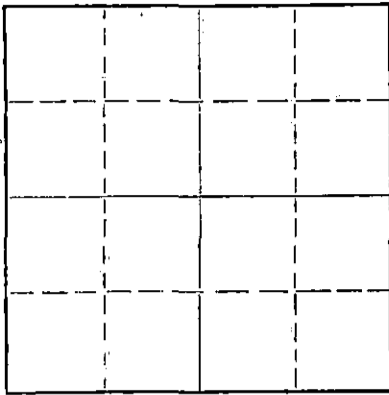

Locate well correctly on above  
Section Plat

Stafford County, Sec. 36 Twp. 22S Rge. 14 (W)  
Location as "NE/CNW%SW%" or footage from lines NW SE SE  
Lease Owner Donald T. Ingling, et al  
Lease Name Symms Well No. 1  
Office Address 615 First National Bank Bldg., Wichita, Kans.  
Character of Well (completed as Oil, Gas or Dry Hole) Dry Hole  
Date well completed February 13 19 68  
Application for plugging filed Verbal Authority  
Application for plugging approved Verbal Authority  
Plugging commenced February 13 19 68  
Plugging completed February 13 19 68  
Reason for abandonment of well or producing formation

If a producing well is abandoned, date of last production 19  
Was permission obtained from the Conservation Division or its agents before plugging was commenced? Yes

Name of Conservation Agent who supervised plugging of this well Archie V. Elving  
Producing formation \_\_\_\_\_ Depth to top \_\_\_\_\_ Bottom \_\_\_\_\_ Total Depth of Well \_\_\_\_\_ Feet  
Show depth and thickness of all water, oil and gas formations.

OIL, GAS OR WATER RECORDS

CASING RECORD

| FORMATION | CONTENT                                  | TO | SIZE   | PUT IN | PULLED OUT |
|-----------|--|----|--------|--------|------------|
|           | STATE CORPORATION COMMISSION             |    | 8-5/8" | 353'   | None       |
|           | CONSERVATION DIVISION<br>Wichita, Kansas |    |        |        |            |
|           |  |    |        |        |            |
|           |  |    |        |        |            |

Describe in detail the manner in which the well was plugged, indicating where the mud fluid was placed and the method or methods used in introducing it into the hole. If cement or other plugs were used, state the character of same and depth placed, from \_\_\_\_\_ feet to \_\_\_\_\_ feet for each plug set.

Filled hole with heavy rotary mud from 3,872 feet (rotary total depth) to 300 feet. Set bottom plug at 300 feet and cemented with 25 sacks cement. Filled hole with heavy rotary mud to 40 feet. Set plug at 40 feet and cemented to cellar with 10 sacks cement, 2 sacks cement in rat hole.

(If additional description is necessary, use BACK of this sheet)

Name of Plugging Contractor H-30, INC.  
Address 200 North Main St., Wichita, Kansas 67202

STATE OF KANSAS, COUNTY OF SEDGWICK, ss.  
Arlo B. Romer (employee of owner) or (owner or operator) of the above-described well, being first duly sworn on oath, says: That I have knowledge of the facts, statements, and matters herein contained and the log of the above-described well as filed and that the same are true and correct. So help me God.

(Signature) Arlo B. Romer  
200 North Main St., Wichita, Kansas  
(Address)

SUBSCRIBED AND SWORN TO before me this 16th day of February, 1968

My commission expires April 21, 1971

Martha Hartpence  
Notary Public.

KANSAS GEOLOGICAL SOCIETY  
KANSAS WELL LOG BUREAU - KANSAS WELL SAMPLE BUREAU  
KANSAS GEOLOGICAL SOCIETY BUILDING  
508 EAST MURDOCK - WICHITA, KANSAS


COMPANY Donald T. Ingling, et al  
FARM Symms NO. 1

SEC. 36 T. 22S R. 14W  
LOC. NW SE SE

TOTAL DEPTH 3,872'  
COMM. February 5, 1968 COMP. February 13, 1968  
SHOT OR TREATED  
CONTRACTOR H-30, INC.  
ISSUED

COUNTY Stafford

KANSAS

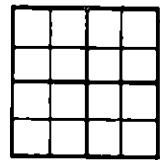

CASING  
20 10  
15 8-5/8" 353' cemented w/300 sks cement ELEVATION 1,931 KB  
12 6  
13 5  
PRODUCTION

FIGURES INDICATE BOTTOM OF FORMATIONS

|                        |       |                     |               |
|------------------------|-------|---------------------|---------------|
| Sand w/Streaks of Clay | 345   | <u>SAMPLE TOPS:</u> |               |
| Clay                   | 352   | Anhydrite           | 810 + 1121    |
| Shale w/Sand Streaks   | 810   | Base Anhydrite      | 840 + 1091    |
| Anhydrite              | 840   | Heebner             | 3,321 - 1390  |
| Shale                  | 1,600 | Brown Lime          | 3,454 - 1,523 |
| Shale w/Lime Streaks   | 1,715 | Lansing K.C.        | 3,471 - 1,540 |
| Lime w/Shale Streaks   | 1,995 | Viola Chert         | 3,768 - 1,837 |
| Lime                   | 2,185 | Simpson Shale       | 3,804 - 1,873 |
| Lime & Shale           | 2,370 | Arbuckle            | 3,852 - 1,921 |
| Shale & Lime           | 2,785 | Rotary T.D.         | 3,872 - 1,941 |
| Lime & Shale           | 2,960 |                     |               |
| Lime                   | 3,330 |                     |               |
| Lime & Shale           | 3,585 |                     |               |
| Lime                   | 3,630 |                     |               |
| Lime & Shale           | 3,770 |                     |               |
| Chert & Lime           | 3,820 |                     |               |
| Lime & Shale           | 3,862 |                     |               |
| Lime                   | 3,872 |                     |               |
| Rotary Total Depth     | 3,872 |                     |               |

RECEIVED  
STATE CORPORATION COMMISSION  
FEB 19 1968  
CONSERVATION DIVISION  
Wichita, Kansas

I hereby certify the above and foregoing to be a true and correct log of the above described well as shown by the drilling reports.

H-30, INC.

Arlo B. Romer  
Arlo B. Romer

STATE OF KANSAS }  
COUNTY OF SEDGWICK } SS

Subscribed and Sworn to before me a Notary Public in and for said county and state this 16th day of February, 1968.

Martha Hartpence  
Martha Hartpence - Notary Public

My Commission Expires:

April 21, 1971