


WELL PLUGGING RECORD

Give All Information Completely
Make Required Affidavit
Mail or Deliver Report to:
Conservation Division
State Corporation Commission
800 B. B. Building
Wichita, Kansas

NORTH

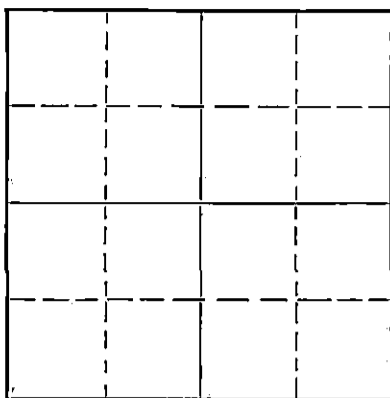

Locate well correctly on above
Section Plat

Stafford County. Sec. 36 Twp. 22 Rge. (E) 14 (W)
Location as "NE/CNW $\frac{1}{4}$ /SW $\frac{1}{4}$ " or footage from lines NE $\frac{1}{4}$ SW $\frac{1}{4}$ NE $\frac{1}{4}$
Lease Owner Musgrove Petroleum Corporation
Lease Name Hart Well No. 2
Office Address 407 K.F.H. Building, Wichita 2, Kansas
Character of Well (completed as Oil, Gas or Dry Hole) Dry Hole
Date well completed March 27 19 50
Application for plugging filed October 13 19 50
Application for plugging approved October 14 19 50
Plugging commenced October 20 19 50
Plugging completed October 25 19 50
Reason for abandonment of well or producing formation Dry

If a producing well is abandoned, date of last production 19
Was permission obtained from the Conservation Division or its agents before plugging was commenced? Yes

Name of Conservation Agent who supervised plugging of this well C. D. Stough
Producing formation Depth to top Bottom Total Depth of Well 384.7 Feet
Show depth and thickness of all water, oil and gas formations.

OIL, GAS OR WATER RECORDS

CASING RECORD

Formation	Content	From	To	Size	Put In	Pulled Out
				8-5/8"	314'	None
				5-1/2"	3690'	3122'

Describe in detail the manner in which the well was plugged, indicating where the mud fluid was placed and the method or methods used in introducing it into the hole. If cement or other plugs were used, state the character of same and depth placed, from feet to feet for each plug set.

Filled hole with mud to 310'. Put in rock bridge to 300'.
Ran 20 sacks of cement. Filled hole to 40' with mud.
Put in rock bridge to 35'. Ran no sacks of cement.

(If additional description is necessary, use BACK of this sheet)

Correspondence regarding this well should be addressed to Musgrove Petroleum Corporation
Address 407 K.F.H. Building
Wichita 2, Kansas

STATE OF KANSAS, COUNTY OF SEDGWICK, ss.
GORDON L. KOELLING (employee of owner) or (owner or operator) of the above-described well,
being first duly sworn on oath, says: That I have knowledge of the facts, statements, and matters herein contained and the log of the above-described well as filed and that the same are true and correct. So help me God.

(Signature) Gordon L. Koelling

(Address)

SUBSCRIBED AND SWORN to before me this 30th day of October 19 50

My commission expires December 5, 1951

22-7377-8 4-49-10M

RECEIVED
STATE CORPORATION COMMISSION
Notary Public.
OCT 31 1950

CONSERVATION DIVISION
Wichita, Kansas

10-31-50

PLUGGING
FILE SEC 36 TWP 22 R 14
BOOK PAGE 35 LINE 19

C.
O
P
Y

C
O
P
Y

MUSGROVE PETROLEUM CORPORATION

Hart #2, NE SW NE 36-22-14
Stafford County, Kansas

0	220	Sand
220	270	Shale
270	290	Shale and shells
290	327	Shale and shells
327	355	Shale and shells
355	700	Red Bed & shells
700	820	Red Bed
820	850	Anhydrite
850	1070	Shale and shells
1070	1400	Shale and shells
1400	1425	Shale and shells
1425	1440	Lime
1440	1605	Shale
1605	1610	Lime
1610	1735	Shale and lime
1735	1850	Shale and lime
1850	1900	Shale and lime
1900	1945	Lime and shale
1945	1960	Shale and lime
1960	2105	Shale and lime
2105	2220	Shale and lime
2220	2265	Shale and lime
2265	2370	Shale and lime
2370	2570	Lime and shale
2570	2730	Shale and lime
2730	2815	Shale and lime
2815	2855	Shale and lime
2855	2930	Shale and lime
2930	2970	Lime
2970	3070	Shale and lime
3070	3195	Shale and lime
3195	3250	Shale and lime
3250	3320	Lime
3320	3410	Lime
3410	3445	Broken lime
3445	3480	Lime
3480	3532	Lime
3532	3589	Lime
3589	3630	Lime
3630	3660	Lime
3660	3720	Lime
3720	3770	Lime
3770	3800	Viola
3800	3831	Lime
3831	3851	Lime
3851		Rotary Total Depth

COMMENCED: 3-13-50
COMPLETED: 3-25-50

GASING RECORD

Set 8-5/8" surface casing at 314',
cemented with 200 sacks.

Set 5-1/2" casing at 3690',
cemented with 100 sacks.

RECEIVED
STATE CORPORATION COMMISSION
OCT 14 1950
CONSERVATION DIVISION
Wichita, Kansas

STATE OF KANSAS)
)SS
COUNTY OF SEDGWICK)

I hereby affirm that the above and foregoing is a true and correct copy of the log of the #2 Hart located NE SW NE Section 36-22-14, Stafford County, Kansas.

ANSCHUTZ DRILLING COMPANY, INC.
By: /s/ H. R. Jensen

Subscribed and sworn to before me this 28th day of March, 1950.

My commission expires September 12, 1953

/s/ Martha Gorges
Notary Public

(SEAL)

