


WELL PLUGGING RECORD

Give All Information Completely
Make Required Affidavit
Mail or Deliver Report to:
Conservation Division
State Corporation Commission
211 No. Broadway
Wichita, Kansas

T 22S NORTH R 18W

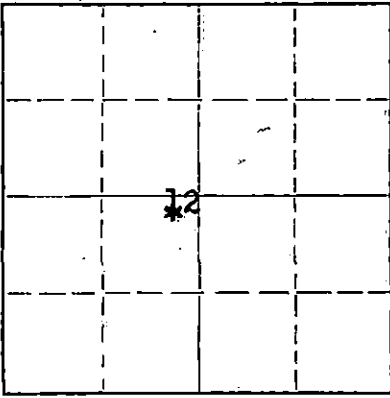

Locate well correctly on above Section Flat

Pawnee County, Sec. 12 Twp. 22S Rge. 18W (E) (W)
Location as "NE/CNW/SW" or footage from lines NE NE SW
Lease Owner Welch and Olsson Drilling Co., Inc.
Lease Name Godfrey Well No. 1
Office Address 203 Rule Building - Wichita, Kansas
Character of Well (completed as Oil, Gas or Dry Hole) _____
Date well completed _____ 19____
Application for plugging filed _____ 19____
Application for plugging approved _____ 19____
Plugging commenced October 1 1956
Plugging completed October 5 1956
Reason for abandonment of well or producing formation _____

If a producing well is abandoned, date of last production _____ 19____
Was permission obtained from the Conservation Division or its agents before plugging was commenced? Yes

Name of Conservation Agent who supervised plugging of this well Brundege
Producing formation _____ Depth to top _____ Bottom _____ Total Depth of Well 8203 Feet
Show depth and thickness of all water, oil and gas formations.

OIL, GAS OR WATER RECORDS

CASING RECORD

FORMATION	CONTENT	FROM	TO	SIZE	PUT IN	PULLED OUT
				8-5/8"	200'	None
				5-1/2"	4202'	2590'

Describe in detail the manner in which the well was plugged, indicating where the mud fluid was placed and the method or methods used in introducing it into the hole. If cement or other plugs were used, state the character of same and depth placed, from _____ feet to _____ feet for each plug set.

Filled the hole with sand from 4203' to 4192' and ran 5 sacks of cement. Pumped in 100 sacks of jell mud and 125 sacks of cement. Checked top of cement at 40'. Mudded the hole to 15', set a rock bridge and ran 5 sacks of cement on top. Plugging completed.

(If additional description is necessary, use BACK of this sheet)

Name of Plugging Contractor West Supply Co., Inc.
Address Chase, Kansas

STATE OF Kansas, COUNTY OF Sedgwick, ss.
R. E. Welch (Signature) R. E. Welch (Name)
(Employer, owner or (owner or operator) of the above-described well, being first duly sworn on oath, says: That I have knowledge of the facts, statements, and matters herein contained and the log of the above-described well as filed and that the same are true and correct. So help me God.
203 Rule Bldg. Wichita, Ks. (Address)

SUBSCRIBED AND SWORN TO before me this 10th day of October, 19 56

My commission expires June 12, 1959

Edith Erker Notary Public.

RECEIVED
STATE CORPORATION COMMISSION

PLUGGING
FILE SEC. 12 T. 22 R. 18W
BOOK PAGE 101 LINE 12

OCT 11 1956
CONSERVATION DIVISION
Wichita, Kansas

WELL LOG.

WELCH & OLSSON DRILLING CO. INC.
AND
NATIONAL COOPERATIVE REFINERY ASSN.

ELEVATION: 2044 R.B.
COMMENCED DRG: 8-9-56
COMPL. DRG: 8-23-56
PRODUCTION: Producer.

CONTRACTOR: WELCH & OLSSON DRILLING CO. INC.

GODFREY #1 NE NE SW of Sec. 12-22-18W,
Pawnee County, Kansas.

Casing Record.

Set 290.10' of 8 5/8" with 175 sacks of cement.
Set 4202' of 5 1/2" with 100 sacks of cement.

<u>FORMATIONS</u>	<u>DEPTHS</u>	<u>FORMATION TOPS.</u>
Sand:	40	Heebner: 3554 (-1510)
Sand, Clay & Shale:	200	Brown Lime: 3643 (-1599)
Shale & Red Bed:	400	Lansing-Ks. City: 3654 (-1610)
Red Bed:	560	Base Kans. City: 3944 (-1900)
Sand:	665	Cherty Conglomerate: 4086 (-2042)
Shale & Red Bed:	700	Misener Sand: 4125 (-2081)
Shale & Red Bed W/sand stks:	850	Viola: 4164 (-2120)
Shale & Shells:	1100	
Anhydrite:	1130	
Shale, Shells & Red Bed:	1250	
Shale & Shells:	1975	
Shale & Lime:	2255	
Lime & Shale:	2430	
Shale & Lime:	3085	
Lime & Shale:	3185	
Shale & Lime:	3295	
Lime & Shale:	3449	
Shale & Lime:	3495	
Lime & Shale:	3660	
Lime:	3770	
Lime & Shale:	3801	
Lime:	3930	
Lime & Chert:	3980	
Lime:	3075	
Shale & Lime:	4092	
Conglomerate:	4158	
Lime, Shale & Chert:	4200 T.D.	

STATE OF KANSAS,)
) SS:
SEDGWICK COUNTY,)

I hereby certify that the above is a true and correct copy of Drillers Log of well drilled in the approximate center of the NE NE SW of Section 12, Township 22, Range 18 West, Pawnee County, Kansas.

WELCH & OLSSON DRILLING COMPANY, INC.

BY *R. A. Welch*
R. A. WELCH

Subscribed and sworn to before me this 29th day of August, 1956.

Edith Erkel
Edith Erkel, Notary Public
STATE CORPORATION COMMISSION

My commission expires:

June 12, 1959

PLUGGING
FILE SEC. 12 T. 22 R. 18W
BOOK PAGE 101 LINE 12

OCT 11 1956
CONSERVATION DIVISION
Wichita, Kansas