


STATE OF KANSAS
STATE CORPORATION COMMISSION

Give All Information Completely
Make Required Affidavit
Mail or Deliver Report to:
Conservation Division
State Corporation Commission
800 Biting Building
Wichita, Kansas

WELL PLUGGING RECORD

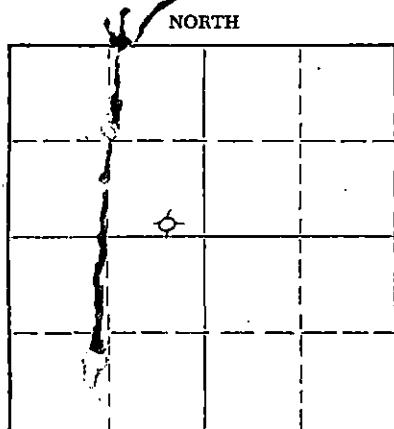

Locate well correctly on above
Section Plat

Pawnee County. Sec. 28 Twp. 22S Rge. 18 (E) (W)
Location as "NE/CNW/SW" or footage from lines C SE SE NW
Lease Owner San Diego Corporation
Lease Name Obee Well No. 1
Office Address 1720 1st National Bldg., Tulsa, Oklahoma
Character of Well (completed as Oil, Gas or Dry Hole) Dry Hole.
Date well completed 6-13-55 19
Application for plugging filed Verbal Application to M. A. Rives 19
Application for plugging approved Verbal Application appvd. 6-13-55 19
Plugging commenced 6-14-55 19
Plugging completed 6-14-55 19
Reason for abandonment of well or producing formation Dry

If a producing well is abandoned, date of last production 19
Was permission obtained from the Conservation Division or its agents before plugging was commenced? Yes

Name of Conservation Agent who supervised plugging of this well M. A. Rives
Producing formation Dry Depth to top Bottom Total Depth of Well 4702 Feet
Show depth and thickness of all water, oil and gas formations.

OIL, GAS OR WATER RECORDS

CASING RECORD

FORMATION	CONTENT	FROM	TO	SIZE	PUT IN	PULLED OUT
Brown Lime	Dense	3782	3788	8-5/8"	254	None
Lansing-Kansas City	SW	3792	4250			
Cherty-Conglomerate	(Dense) SW	4250	4324			
Mississippian	SW	4324	4376			
Viola	SW	4451	4532			
Arbuckle	SW	4680	4702TD			

Describe in detail the manner in which the well was plugged, indicating where the mud fluid was placed and the method or methods used in introducing it into the hole. If cement or other plugs were used, state the character of same and depth placed, from feet to feet for each plug set.

- Hole filled with mud.
- 8-5/8" Halliburton plug pumped to 218 ft w/ 82 sacks of common cement. Top of cement in surface casing approx. 4 ft. from surface.

RECEIVED
STATE CORPORATION COMMISSION

JUN 18 1955

CONSERVATION DIVISION
Wichita, Kansas

6-18-1955

(If additional description is necessary, use BACK of this sheet)

Name of Plugging Contractor (Garvey Drilling Co., -Rotary Drilling tools-Rotary Contractor)
Address 305 East 3rd Street, Wichita, Kansas

STATE OF Oklahoma, COUNTY OF Tulsa, ss.
R. B. Wilkins (employee of owner) or (owner or operator) of the above-described well, being first duly sworn on oath, says: That I have knowledge of the facts, statements, and matters herein contained and the log of the above-described well as filed and that the same are true and correct. So help me God.

(Signature)

1720 First Nat'l Bldg., Tulsa, Okla.
(Address)

SUBSCRIBED AND SWORN TO before me this 17 day of June, 1955

Helen Jeanne Parks

Notary Public.

My commission expires August 24, 1957

PLUGGING
BOOK PAGE 22 LINE 13

SAN DIEGO CORPORATION-OBEE WELL NO. 1

C SE SE NW Sec. 28; T 22S; R 18 W,
Pawnee County, Kansas

WELL LOG

Well Spudded 5-26-55 @ 5:15 P.M.

Set 8-5/8" surface pipe @ 254'; cemented w/ 175 sx cement. Cement
circulated to surface.

Top Brown Lime @ 3782.

Top Lansing @ 3792 (all zones salt water bearing).

Top Cherty Congl. @ 4250 (salt water).


Top Mississippian @ 4324 (salt water).

Top Viola @ 4451 (salt water).

Top Arbuckle @ 4680 (salt water).

TD 4702.

Well P & A 6-14-55

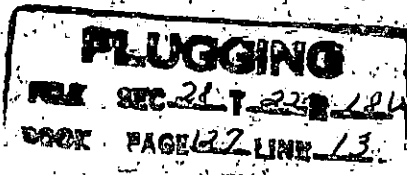

RECEIVED
STATE CORPORATION COMMISSION
JUN 18 1955
CONSERVATION DIVISION
Wichita, Kansas