


WELL PLUGGING RECORD

Give All Information Completely
Make Required Affidavit
Mail or Deliver Report to:
Conservation Division
State Corporation Commission
211 No. Broadway
Wichita, Kansas

Pawnee County, Sec. 9 Twp. 22S Rge. 18 (EX) (W)

NORTH

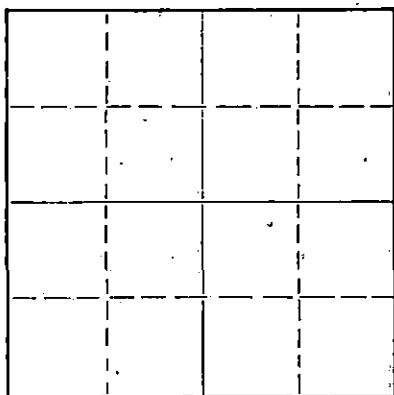

Locate well correctly on above
Section Plat

Location as "NE/CNW/SW" or footage from lines. SE SE SW
Lease Owner Rooney-Siegfried-Thomas & Welch & Olsson Drlg. Co. Inc
Lease Name Meckfessel Well No. C
Office Address 203 Rule Bldg. Wichita, Ks. & Box 324, Great Bend, Ks
Character of Well (completed as Oil, Gas or Dry Hole) Dry Hole
Date well completed 12-1 19 56
Application for plugging filed 12-1 19 56
Application for plugging approved 12-2 19 56
Plugging commenced 12-2 19 56
Plugging completed 12-2 19 56
Reason for abandonment of well or producing formation D & A

If a producing well is abandoned, date of last production None 19____
Was permission obtained from the Conservation Division or its agents before plugging was commenced? Yes

Name of Conservation Agent who supervised plugging of this well R. M. Brundage, Box 283, Hoisington, Ks.
Producing formation _____ Depth to top _____ Bottom _____ Total Depth of Well 4319 Feet
Show depth and thickness of all water, oil and gas formations.

OIL, GAS OR WATER RECORDS

CASING RECORD

FORMATION	CONTENT	FROM	TO	SIZE	PUT IN	PULLED OUT
				8 5/8	1142.93	None
				8 5/8	245.39	None

Describe in detail the manner in which the well was plugged, indicating where the mud fluid was placed and the method or methods used in introducing it into the hole. If cement or other plugs were used, state the character of same and depth placed, from _____ feet to _____ feet for each plug set.

Made 10' plug from 3 x 12 lumber. Cut up wire line and put 2' of wire on top of wood plug. Put in 4 sacks of hulls on top of wire.
Set plug, put 500# egg rock on top of plug, cemented with 50 sacks of cement through drill pipe with Service Truck at 310'.
Added 1/2 sacks of hulls and cemented with 20 sacks of cement through drill pipe with Service Truck. Bulk cement used and cemented by Sun Cementing Co.

RECEIVED
STATE CORPORATION COMMISSION

DEC 7 - 1956 12-7-56

CONSERVATION DIVISION
Wichita, Kansas

Name of Plugging Contractor Welch & Olsson Drilling Co. Inc.
Address 203 Rule Bldg. Wichita, Kansas.

STATE OF Kansas, COUNTY OF Sedgwick, ss.
R.E. Welch (employee of owner) or (owner or operator) of the above-described well, being first duly sworn on oath, says: That I have knowledge of the facts, statements, and matters herein contained and the log of the above-described well as filed and that the same are true and correct. So help me God.

(Signature) [Signature]
203 Rule Bldg. Wichita, Ks.
(Address)

SUBSCRIBED AND SWORN TO before me this 6 day of December, 19 56

My commission expires June 12, 1959
Edith Erker Notary Public.

PLUGGING
FILE - SEC. 9 T. 22 R. 18W
BOOK PAGE 121 LINE 42

WELL LOG.

ROONEY-SEIGFRIED-THOMAS,
Box 324, Great Bend, Kansas.

ELEVATION: 2058 R.B.

WELCH & OLSSON DRILLING COMPANY, INC.
203 Rule Bldg.
Wichita, Kansas.

Comm. Drlg: 11-15-56

Compl. Drlg: 12-2-56

Production: D & A

CONTRACTOR: WELCH & OLSSON DRILLING CO. INC.
203 Rule Bldg. Wichita, Kansas.

MECKFESSEL "C"
SE SE SW 9-22S-18W, Pawnee County, Kansas.

Casing Record.

11-16-56: Set 1142.93 of 8 5/8" with 450 sacks of cement.
11-20-56: Set 245.39 of 8 5/8" with 200 sacks of cement.

(Figures indicated bottom of formations.)

<u>FORMATIONS</u>	<u>DEPTHS.</u>
Sand & Shale:	300
Shale:	400
Shale & Red Bed:	565
Sand:	770
Red Bed & Shale:	1126
Anhydrite:	1130
Cement:	1130 1/2
Iron:	1131
Iron & Anhydrite:	1141 (Hole abandoned at 1141'. Skidded rig 18' East, and drilled new hole.)
Shale, Sand & Clay:	245
Shale & Red Bed:	550
Sand:	675
Red Bed:	720
Red Bed & Shale:	1151
Anhydrite:	1153
Shale & Shells:	1955
Shale & Lime:	2220
Lime & Shale:	2453
Shale & Lime:	3295
Lime & Shale:	3360
Lime:	3455
Lime & Shale:	3615
Shale & Lime:	3700
Lime:	4065
Lime & Shale:	4140
Lime:	4173
Conglomerate:	4300
Conglomerate & Lime:	4319 T.D.

STATE OF KANSAS,)
) SSP
SEDGWICK COUNTY,)

RECEIVED
STATE COMMISSION OF CONSERVATION
DEC 7 - 1956
CONSERVATION DIVISION
Wichita, Kansas

I hereby certify that the above is a true and correct copy of Drillers Log of Well drilled in the SE SE SW of Section 9, Township 22 South, Range 18 W. Pawnee County, Kansas.

PLUGGING
WELCH & OLSSON DRILLING COMPANY, INC.
FILE SEC 9 T 22 R 18W
BOOK PAGE 118 LI BY 19
R. E. WELCH

Subscribed and sworn to before me this 6th day of December, 1956.

My comm. expires: June 12, 1959

Edith Erker, Notary Public.

WELL LOG.

ROONEY-SEIGFRIED-THOMAS,
Box 324, Great Bend, Ks.
WELCH & OLSSON DRILLING COMPANY, INC.
203 Rule Bldg.
Wichita, Kansas.

ELEVATION: 2058 R.B.
Comm. Drlg: 11-15-56
Compl. Drlg: 12-2-56
Production: D & A

CONTRACTOR: WELCH & OLSSON DRILLING CO. INC.
203 Rule Bldg. Wichita, Kansas.

MECKFESSEL "C"
SE SE SW 9-22S-18W, Pawnee County, Ks.

Casing Record.

Set 1142.93 of 8 5/8" with 450 sacks of cement
" 245.39 of 8 5/8" with 200 sacks of cement.

(Figures indicated bottom of formations.)

<u>FORMATIONS</u>	<u>DEPTHS.</u>	
Sand & Shale:	300	
Shale:	400	
Shale & Red Bed:	565	
Sand:	770	
Red Bed & Shale:	1126	
Anhydrite:	1130	
Cement:	1130½	
Iron:	1131	
Iron & Anhydrite:	1141	(Hole abandoned at 1141'. Skidded rig
Shale, Sand & Clay:	245	-18' East, and drilled new hole.)
Shale & Red Bed:	550	
Sand:	675	
Red Bed:	740	
Red Bed & Shale:	1151	
Anhydrite:	1153	
Shale & Shells:	1955	
Shale & Lime:	2220	
Lime & Shale:	2453	
Shale & Lime:	3295	
Lime & Shale:	3360	
Lime:	3455	
Lime & Shale:	3615	
Shale & Lime:	3700	
Lime:	4065	
Lime & Shale:	4140	
Lime:	4173	
Conglomerate:	4300	
Conglomerate & Lime:	4319 T.D.	

RECEIVED
STATE CORPORATION COMMISSION
DEC 7 - 1956
CONSERVATION DIVISION
Wichita, Kansas

STATE OF KANSAS,)
) SS:
SEDGWICK COUNTY,)

I hereby certify that the above is a true and correct copy of Drillers Log of well drilled in the SE SE SW of Section 9, Township 22 South, Range 18W, Pawnee County, Ks.

WELCH & OLSSON DRILLING COMPANY, INC.
PLUGGING
FILE SEC 9 T. 22 R. 18W
BOOK PAGE 121 LINE 42

R. E. Welch
R. E. WELCH

Subscribed and sworn to before me this 6th day of December, 1956.

Edith Erker
Edith Erker, Notary Public.

My commission expires:
June 12, 1959