

STATE OF KANSAS
STATE CORPORATION COMMISSION


15-075-20209-0000

WELL PLUGGING RECORD

Give All Information Completely
Make Required Affidavit
Mail or Deliver Report to
Conservation Division
State Corporation Comm.
245 North Water
Wichita, KS 67202

Hamilton County, Sec. 8 Twp. 23 Rge. 41 E/W
Location as "NE/CNW/SW" or footage from lines
1980' FNL & 1980' FWL

Lease Owner Wayman W. Buchanan
Lease Name Jones Well No. 1
Office Address 3000 N. Garfield, Ste. 210, Midland, TX 79701
Character of Well (Completed as Oil, Gas or Dry Hole)
Gas

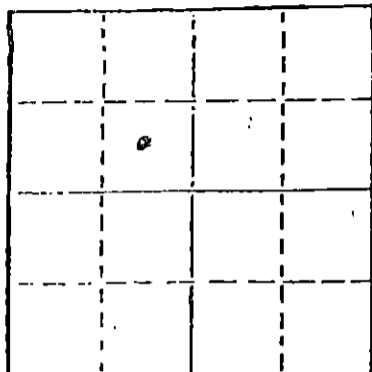

Locate well correctly on above
Section Plot

Date Well completed 7-20-78 19
Application for plugging filed 6-10-81 19
Application for plugging approved 6-15-81 19
Plugging commenced 6-25-81 19
Plugging completed 6-25-81 19

Reason for abandonment of well or producing formation
Non Commercial Value

If a producing well is abandoned, date of last production
October 10, 1980 19

Was permission obtained from the Conservation Division or
its agents before plugging was commenced? yes

Name of Conservation Agent who supervised plugging of this well Mr. Thomas
Producing formation Ft. Riley Depth to top 2512' Bottom 2524' Total Depth of Well 2550'
Show depth and thickness of all water, oil and gas formations.

OIL, GAS OR WATER RECORDS

CASING RECORD

FORMATION	CONTENT	FROM	TO	SIZE	PUT IN	PULLED OUT
Surface				8 5/8"	329'	0
Production				4 1/2"	2550'	0

Describe in detail the manner in which the well was plugged, indicating where the mud fluid
was placed and the method or methods used in introducing it into the hold. If cement or other
plugs were used, state the character of same and depth placed, from _____ feet to
_____ feet for each plug set.

Pump 2 sks. hulls & 20 sks. cement to 2280'

Displaced w/ mud to 500'

Pumped 20 sks. cement 500' to 240'

Displaced 2/ mud to 60'

Put bridge & 5 sks. cement 60' to 0'

Cut off 8 5/8", 42" below ground level

RECEIVED
STATE CORPORATION COMMISSION

AUG 21 1981 08-21-81

CONSERVATION DIVISION
Wichita, Kansas

(If additional description is necessary, use BACK of this sheet)

Name of Plugging Contractor Midwest Casing Pulling
Ks. permit #766

STATE OF KANSAS COUNTY OF HASKELL, ss.
I, Edgar J. Eves (owner or operator)
of the above-described well, being first duly sworn on oath, says: That I have knowledge of
the facts, statements, and matters herein contained and the log of the above-described well
as filed and that the same are true and correct. So help me God.

(Signature) Edgar J. Eves
Box F, Sublette, Ks. 67877
(Address)

SUBSCRIBED AND SWORN TO before me this 30th day of June, 19 81

Sondra L Eves
Notary Public.

My commission expires 12-6-84

