


WELL PLUGGING RECORD

Give All Information Completely
Make Required Affidavit
Mail or Deliver Report to:
Conservation Division
State Corporation Commission
800 Bittling Building
Wichita, Kansas

NORTH

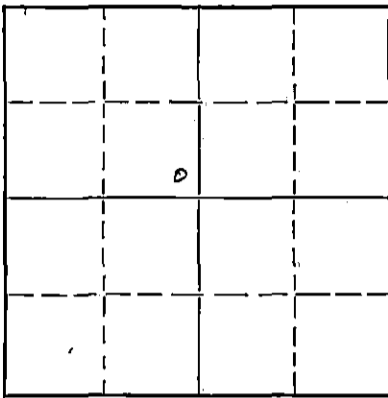

Locate well correctly on above
Section Plat

Stafford County, Sec. 6 Twp. 22 Rge. (E) 14 (W)
Location as "NE/CNW $\frac{1}{4}$ SW $\frac{1}{4}$ " or footage from lines SE SE NW
Lease Owner Westgate-Greenland Oil Company
Lease Name Russell Well No. 1
Office Address 1009 Central Building, Wichita 2, Kansas
Character of Well (completed as Oil, Gas or Dry Hole) dry hole
Date well completed July 3, 1951 19
Application for plugging filed July 3, 1951 (orally) 19
Application for plugging approved July 3, 1951 19
Plugging commenced July 3, 1951 19
Plugging completed 3 A.M. on July 4, 1951 19
Reason for abandonment of well or producing formation

If a producing well is abandoned, date of last production 19
Was permission obtained from the Conservation Division or its agents before plugging was commenced? yes

Name of Conservation Agent who supervised plugging of this well M. A. Rives
Producing formation Depth to top Bottom Total Depth of Well Feet
Show depth and thickness of all water, oil and gas formations.

OIL, GAS OR WATER RECORDS

CASING RECORD

Formation	Content	From	To	Size	Put In	Pulled Out
Surface		0	258	8 5/8"	258'	none

Describe in detail the manner in which the well was plugged, indicating where the mud fluid was placed and the method or methods used in introducing it into the hole. If cement or other plugs were used, state the character of same and depth placed, from feet to feet for each plug set.
Filled hole with heavy mud from 3893 to 250 feet
Set plug at 250 feet and ran 15 sacks cement to 210 feet
Filled with heavy mud from 210 feet to 40 feet
Set plug at 40 feet and ran 10 sacks cement to cellar base.

RECEIVED
STATE CORPORATION COMMISSION
JUL - 9 1951
CONSERVATION DIVISION
Wichita, Kansas
7-9-51

(If additional description is necessary, use BACK of this sheet)
Correspondence regarding this well should be addressed to Westgate-Greenland Oil Company
Address 1009 Central Building, Wichita 2, Kansas

STATE OF Kansas, COUNTY OF Sedgwick, ss.
G. E. Bitler (employee of owner) or ~~owner or operator~~ of the above-described well,
being first duly sworn on oath, says: That I have knowledge of the facts, statements, and matters herein contained and the log of the above-described well as filed and that the same are true and correct. So help me God.

(Signature) *G. E. Bitler*
1009 Central Building, Wichita 2, Kansas
(Address)

SUBSCRIBED AND SWORN TO before me this 7th day of July, 1951
Esther Russell
Notary Public.

My commission expires May 25, 1953. 23-3278-a 4-50-10M

PLUGGING
FILE SEC 67-41-142
BOOK PAGE 92 LINE 21

COMPANY: Westgate Greenland Oil Co.
 CONTRACTOR: Jackson Drilling Corporation
 FARM: Russell #1
 LOCATION: SE SE NW Section 6-22-14W
 Stafford County, Kansas
 ELEVATION: 1961 DF
 COMMENCED: June 19, 1951
 COMPLETED: July 4, 1951

0	to	215	Sand
215	to	258	Shale & shells
258	to	290	Shale
290	to	330	Sand & red bed
330	to	895	Red bed
895	to	925	Anhydrite
925	to	1190	Shale, salt & shells
1190	to	1475	Shale & shells
1475	to	1600	Shale & red bed
1600	to	1700	Shale
1700	to	1715	Lime & shale
1715	to	2030	Lime
2030	to	3364	Lime & shale
3364	to	3400	Shale
3400	to	3470	Shale & lime
3470	to	3688	Lime
3688	to	3760	Shale & lime
3760	to	3796	Conglomerate
3796	to	3826	Chert
3826	to	3889	Conglomerate
3889	to	3895	Arbuckle
		3895 T.D. (RB)	

(RB)
 8 5/8" - 2 1/2" casing set at 258 feet. Cemented with 200 sacks cement and 3 sacks calcium chloride.
 Drill stem test 3588-3596 - Recovered 60 feet of heavy oil cut mud and 150 feet of salt water - open 1 1/4 hours.
 Drill stem test 3612-3633 - Open 1 hour. Recovered 120 feet heavy oil cut mud.
 3874-93
 Drill stem test @ 3895. Open 45 minutes. Recovered 2930 feet salt water.

Tops: Lansing 3476 Anhydrite-895; Conglomerate-3757.
 Arbuckle 3889-3879. Brown Lime-3456. Viola -3767.

Dry and abandoned.

All measurements from top of derrick floor. STATE OF KANSAS COMMISSIONER OF GEOL.

JUL 12 1951

CONSERVATION DIVISION
 CERTIFICATE Wichita, Kansas

I, Clare A. Stewart, do hereby certify that the above and foregoing is a true and correct copy of log of the Russell #1, Section 6-22-14W, Stafford County, Kansas, as reflected by files of the Jackson Drilling Corporation.

PLUGGING
 FILE SEC 6-T-14W
 BOOK PAGE 92 LINE 21

Clare A. Stewart
 Clare A. Stewart

Subscribed and sworn to before me, a Notary Public, within and for Johnson County, Kansas, this 10th day of July, 1951.

Dorothy J. Wilson
 Dorothy J. Wilson