

STATE OF KANSAS
STATE CORPORATION COMMISSION


WELL PLUGGING RECORD

Give All Information Completely
Make Required Affidavit
Mail or Deliver Report to:
Conservation Division
State Corporation Commission
800 Bittling Building
Wichita, Kansas

OR
FORMATION PLUGGING RECORD

Strike out upper line
when reporting plug-
ging off formations.

NORTH

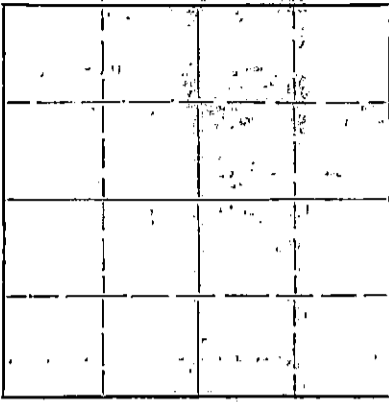

Locate well correctly on above
Section Plat.

Stafford County. Sec. 14 Twp. 22S Rge. 13 (E) W. (W)
Location as "NE $\frac{1}{4}$ NW $\frac{1}{4}$ SW $\frac{1}{4}$ " or footage from lines NW NW SE
Lease Owner Crown Oil Company, Inc. et al
Lease Name Witt Well No. 1
Office Address Odell at 10th Street, Great Bend, Kansas
Character of Well (completed as Oil, Gas or Dry Hole) Dry Hole
Date well completed July 6 19 49
Application for plugging filed July 6 19 49
Application for plugging approved 19
Plugging commenced July 6 19 49
Plugging completed July 6 19 49
Reason for abandonment of well or producing formation No production

If a producing well is abandoned, date of last production 19
Was permission obtained from the Conservation Division or its agents before plugging was com-
menced?

Name of Conservation Agent who supervised plugging of this well Mr. Stough
Producing formation Depth to top Bottom Total Depth of Well Feet
Show depth and thickness of all water, oil and gas formations.

OIL, GAS OR WATER RECORDS

CASING RECORD

Formation	Content	From	To	Size	Put In	Pulled Out

Describe in detail the manner in which the well was plugged, indicating where the mud fluid was placed and the method or methods used in introducing it into the hole. If cement or other plugs were used, state the character of same and depth placed, from feet to feet for each plug set.

Plugged hole with heavy rotary mud 3815 to 308
308-1 Plug and 15 sacks of cement
Heavy rotary mud to 40 feet top
Plug at 40 feet with 15 sacks cement to within 7 feet of top

RECEIVED
Conservation Div.
JUL 12 1949
STATE CORPORATION
COMMISSION
KANSAS

7-12-49

(If additional description is necessary, use BACK of this sheet)

Correspondence regarding this well should be addressed to Crown Oil Company, Inc.
Address Odell at 10th Street, Great Bend, Kansas

STATE OF KANSAS, COUNTY OF BARTON, ss.
H. R. Buick (employee of owner) or (~~owner or operator~~) of the above-described well,

being first duly sworn on oath, says: That I have knowledge of the facts, statements, and matters herein contained and the log of the above-described well as filed and that the same are true and correct. So help me God.

(Signature) H. R. Buick

St. John, Kansas
(Address)

SUBSCRIBED AND SWORN to before me this 7th day of July 19 49

Terry Pascock
Notary Public.

My commission expires June 13, 1951.

22-2625 2-48-1516
PLUGGING
FILE SEC 14 T 22 R 13W
BOOK PAGE 104 LINE 78

D R I L L E R ' S L O G

COMPANY: CROWN OIL COMPANY, INC. et al LOCATION: NW NW SE 14-22S-13W
 CONTRACTOR: HARMS & KNIGHT DRILLING CO. Stafford County,
 FARM NAME: No. 1 WITT Kansas
 Commenced: 6-23-49 ELEVATION: 1900 DF
 COMPLETED: 7-6-49

CASING USED: 8-5/8" at 308' with 200 sacks

Sand	40
Sand and Red Bed	307
Shells	308
Red Bed Sand & Shale	755
Anhydrite	820
Anhydrite & Shale Shells	1208
Shale and Shells	1735
Shale and Lime	2410
Shale and Shells	2635
Shale	2800
Shale and Shells	2990
Lime and Shale	3330
Lime	3391
Shale and Lime	3505
Lime	3552
Shale and Lime	3660
Lime and Chert	3740
Chert and Shale	3765
Shale & Lime	3790
Lime Chert	3808
Lime	3815
Total Depth	3815

STATE OF KANSAS)
) SS
 COUNTY OF BARTON)

I, the undersigned, being duly sworn on oath state that the above statement and log is true and a correct record and log of the well drilled at the location above-described.

CROWN OIL COMPANY, INC.

By *Sam P. Hilton*
 Secretary

Subscribed and sworn to before me this 7th day of July, 1949.

Henry Peacock
 Notary Public

My Commission expires June 13, 1951.

RECEIVED
 Conservation Div.
 JUL 12 1949
 STATE CORPORATION
 COMMISSION
 KANSAS

PLUGGING
 WELL NO. 14-22S-13W
 BOOK PAGE 104 LINE 29