

STATE OF KANSAS
STATE CORPORATION COMMISSION


WELL PLUGGING RECORD

OR
FORMATION PLUGGING RECORD

Strike out upper line when reporting plugging of formations.

Give All Information Completely
Make Required Affidavit
Mail or Deliver Report to:
Conservation Division
State Corporation Commission
800 Bittling Building
Wichita, Kansas

Stafford County. Sec. 14 Twp. 22S Rge. (E) 13 (W)
Location as "NE 1/4 NW 1/4 SW 1/4" or footage from lines. NE 1/4 of NE 1/4 of SE 1/4
Lease Owner. G. W. Keyes Drilling Company
Lease Name. F. F. Witt Well No. 1
Office Address. Ellinwood, Kansas
Character of Well (completed as Oil, Gas or Dry Hole) Dry Hole
Date well completed. August 29, 1944. 19
Application for plugging filed. September 8, 1944, verbal. 19
Application for plugging approved. September 8, 1944, verbal. 19
Plugging commenced. September 10, 1944. 19
Plugging completed. September 14, 1944. 19
Reason for abandonment of well or producing formation. Dry hole.

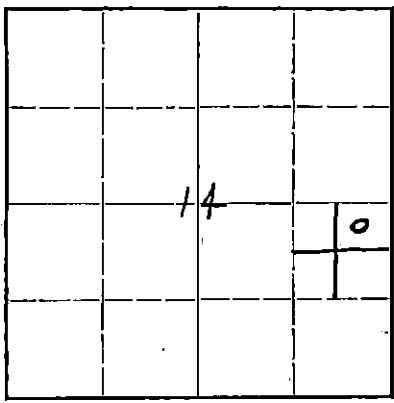

Locate well correctly on above Section Plat

If a producing well is abandoned, date of last production - - - 19
Was permission obtained from the Conservation Division or its agents before plugging was commenced? Yes.

Name of Conservation Agent who supervised plugging of this well. Mr. Kerr.
Producing formation. none. Depth to top. Bottom. Total Depth of Well. 3780 Feet
Show depth and thickness of all water, oil and gas formations.

OIL, GAS OR WATER RECORDS

CASING RECORD

Formation	Content	From	To	Size	Put In	Pulled Out
Surface Production		0'	272'	10 3/4"	272	none
		0'	3739'	5 1/2"	3739'	3051' 8"

Describe in detail the manner in which the well was plugged, indicating where the mud fluid was placed and the method or methods used in introducing it into the hold. If cement or other plugs were used, state the character of same and depth placed, from _____ feet to _____ feet for each plug set.
5 sacks of cement were run in bottom. Hole was mudded back to 275 feet, bridged and cemented with 15 sacks. Hole mudded to 10' and cemented with 5 sacks, bringing cement to base of cellar.

PLUGGING
FILE 14 22R13W
BOOK PAGE 131 LINE 4

(If additional description is necessary, use BACK of this sheet)

Correspondence regarding this well should be addressed to G. W. Keyes Drilling Company, Ellinwood, Kansas.

STATE OF Kansas, COUNTY OF Barton, ss.
G. W. Keyes (employee of owner) or (owner or operator) of the above-described well,

being first duly sworn on oath, says: That I have knowledge of the facts, statements, and matters herein contained and the log of the above-described well as filed and that the same are true and correct. So help me God.

(Signature) G. W. Keyes 9-25-44
Ellinwood, Kansas (Address)

SUBSCRIBED AND SWORN TO before me this 23 rd day of September, 1944.

My commission expires July 7, 1948. Notary Public.

WELL LOG

G. W. Keyes Drilling Co., owner

T. F. Witt # 1

NE 1/4 of NE 1/4 of SE 1/4 Section 14-22-13W Stafford County Kansas

0	to	145	Sand
		240	Shale
		272	Red rock
		724	Red rock
		752	Anhydrite
		840	Shale and shells
		1280	Shale, red bed
		1330	Salt
		1590	Shale and shells
		1620	Anhydrite
		1735	Broken Lime
		1850	Broken Lime, Sandy
		1910	Lime
		2000	Shale and shells
		2015	Broken Lime
		2110	Lime
		2220	Lime and shale
		2270	Broken Lime
		2685	Shale and shells
		2820	Lime
		2930	Lime and shale, broken
		3030	Shale and lime
		3995	Lime
		3185	Lime, broken
		3350	Lime
		3375	Shale
		3549	Lime
		3556	Soft Lime
		3600	Lime
		3635	Conglomerate
		3638	Lime, cherty
		3678	Lime
		3738	Shale
		3741	Lime
		3741	Total rotary depth
		3773	Lime, salt water encountered
		3780	Lime
		3780	Total depth

FILE 14-22-13W
BOOK 131 LINE 4

STATE OF KANSAS, COUNTY OF BARTON, SS.

G. W. Keyes owner of the above-described well, being first duly sworn on oath, says: That I have knowledge of the facts, statements, and matters herein contained and the log of the above-described well as filed and that the same are true and correct. So help me God.

Subscribed and Sworn to before me this _____ day of
September, 1944.

My commission expires July 7, 1948.

Notary Public.