


STATE OF KANSAS
STATE CORPORATION COMMISSION
CONSERVATION DIVISION
P. O. BOX 17027
WICHITA, KANSAS 67217

FORM CP-4

WELL PLUGGING RECORD

Stafford County, Sec. 14 Twp. 22 Rge. 13W (E) (W)

Location as "NE/CNW/SW" or footage from lines SW SW NW
Lease Owner Southern States Oil Company
Lease Name HAHN Well No. B-1
Office Address 1012 Walnut, Great Bend, Kansas 67530
Character of Well (completed as Oil, Gas or Dry Hole) Dry Hole
Date well completed December 7 19 75
Application for plugging filed December 7 19 75
Application for plugging approved December 7 19 75
Plugging commenced December 7 19 75
Plugging completed December 7 19 75
Reason for abandonment of well or producing formation Dry Hole

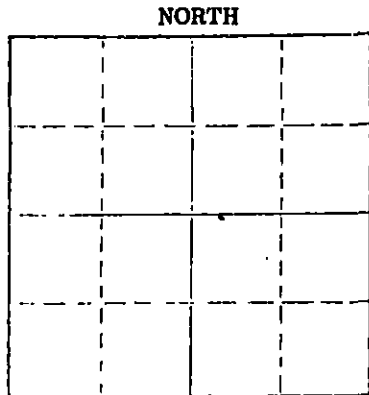

Locate well correctly on above Section Plat

If a producing well is abandoned, date of last production 19
Was permission obtained from the Conservation Division or its agents before plugging was commenced? yes

Name of Conservation Agent who supervised plugging of this well G. R. Biberstein
Producing formation _____ Depth to top _____ Bottom _____ Total Depth of Well 3800 Feet
Show depth and thickness of all water, oil and gas formations.

OIL, GAS OR WATER RECORDS

CASING RECORD

FORMATION	CONTENT	FROM	TO	SIZE	PUT IN	PULLED OUT

Describe in detail the manner in which the well was plugged, indicating where the mud fluid was placed and the method or methods used in introducing it into the hole. If cement or other plugs were used, state the character of same and depth placed, from _____ feet to _____ feet for each plug set.

Hole full of heavy mud. Plug @ 250' w/35 sacks cement thru drill pipe.
Mud to 40' w/1/2 sack hulls plug and 15 sacks cement.
2 sacks in rat hole.

RECEIVED
STATE CORPORATION COMMISSION
DEC 10 1975
12-10-75

(If additional description is necessary, use BACK of this sheet)
Name of Plugging Contractor Duke Drilling Co.
Address Box 823, Great Bend, Kansas 67530

STATE OF KANSAS COUNTY OF BARTON
Larry Curtis (employee of owner) or (operator) of the above-described

well, being first duly sworn on oath, says: That I have knowledge of the facts, statements, and matters herein contained and the log of the above-described well as filed and that the same are true and correct. So help me God

(Signature) Larry Curtis
Box 823, Great Bend, Kansas 67530
(Address)

SUBSCRIBED AND SWORN TO before me this 9th day of December 19 75

My commission expires April 11, 1978
Notary Public.

DRILLERS' WELL LOG

DATE COMMENCED: December 2, 1975
DATE COMPLETED: December 7, 1975

Southern States Oil Company
HAHN B-1
SW SW NW of Sec 14-T22-R13W
Stafford County, Kansas

ELEVATION: 1893 K.B.

0 - 240'	Sand
240 - 739'	Red Bed
739 - 762'	Anhydrite
762 - 1670'	Red Bed
1670 - 3259'	Lime and Shale
3259 - 3263'	Shale
3263 - 3278'	Lime and Shale
3278 - 3291'	Lime
3291 - 3395'	Shale
3395 - 3675'	Lime and Shale
3675 - 3800'	Lime, Shale, Chert, Sand
3800'	RTD

FORMATION TOPS

Anhydrite	739
Heebner	3259
Toronto	3278
Douglas	3291
Brown Lime	3395
Lansing	3415
Cong.	3675
RTD	3800

SURFACE PIPE:

Set 266' of used 8 5/8", 28#
pipe w/150 sacks Common,
3% Gel, 3% cc and 150
sacks Common, 2% Gel, 3% cc.

AFFIDAVIT

STATE OF KANSAS }
COUNTY OF BARTON } ss.

Larry Curtis, of lawful age, does swear and state that the facts and statements herein contained are true and correct to the best of his knowledge.

Larry Curtis

Subscribed and sworn to before me this 9th day of December, 1975.

Notary Public

My Commission Expires: April 11, 1978

RECEIVED
STATE OF KANSAS
DEC 10 1975
COMMISSIONER OF REVENUE
Wichita, Kansas