


Corp. Comm.

15.185-02036-0000

STATE OF KANSAS
STATE CORPORATION COMMISSION

WELL PLUGGING RECORD


OR
FORMATION PLUGGING RECORD

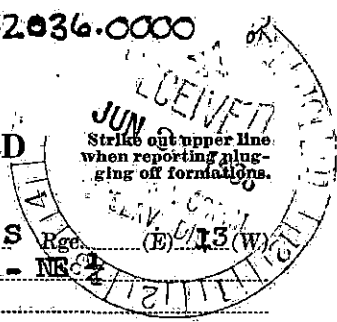

Give All Information Completely
Make Required Affidavit
Mail or Deliver Report to:
Conservation Division
State Corporation Commission
800 Bittling Building
Wichita, Kansas

NORTH R 13 W

Stafford County. Sec. 14 Twp. 22 S Rge. (E) 13 (W)
Location as "NE 1/4 NW 1/4 SW 1/4" or footage from lines. NW 1/4 - NW 1/4 - NE 1/4
Lease Owner Stanolind Oil and Gas Company
Lease Name Emil Fischer Well No. 1
Office Address Box 591, Tulsa, Oklahoma
Character of Well (Completed as Oil, Gas or Dry Hole) Dry Hole
Date, well completed June 1 1938
Application for plugging filed June 2 (verbal) 1938
Application for plugging approved June 2 (verbal) 1938
Plugging Commenced June 2 1938
Plugging Completed June 2 1938
Reason for abandonment of well or producing formation Dry Hole

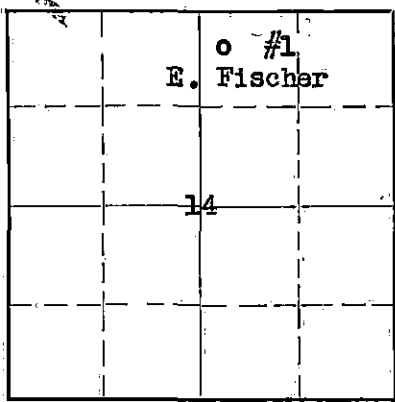

T
22
S

Locate well correctly on above
Section Plat

If a producing well is abandoned, date of last production 193
Was permission obtained from the Conservation Division or its agents before plugging was commenced?
Yes

Name of Conservation Agent who supervised plugging of this well Ed Sheil
Producing formation Siliceous Depth to top 3776 / Bottom 3805 Total Depth of Well 3805 Feet.
Show depth and thickness of all water, oil and gas formations.

OIL, GAS OR WATER RECORDS


CASING RECORD

Formation	Content	From	To	Size	Put In	Pulled Out
Lansing		3385		10-3/4 OD	255' 2" Thd off.	None
Siliceous		3776	3805	6" OD	3770' 10" Thd off.	None

Describe in detail the manner in which the well was plugged, indicating where the mud fluid was placed and the method or methods used in introducing it into the hole. If cement or other plugs were used, state the character of same and depth placed, from _____ feet to _____ feet for each plug set.

150 ft heavy mud in bottom of hole. Wooden plug in top of casing.

X Temporarily abandoned

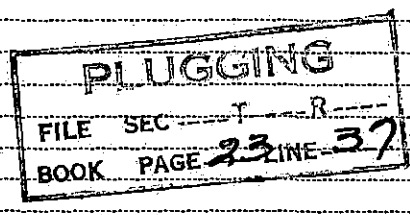

(If additional description is necessary, use BACK of this sheet)

Correspondence regarding this well should be addressed to Stanolind Oil and Gas Company
Address Box 591
Tulsa, Oklahoma

STATE OF Kansas, COUNTY OF Barton, ss.
(employee of owner) or (owner or operator) of the above-described well,
being first duly sworn on oath, says: That I have knowledge of the facts, statements, and matters herein contained and the log of the above-described well as filed and that the same are true and correct. So help me God.

(Signature) *H. H. Pethig*
Ellinwood, Kansas
(Address)

SUBSCRIBED AND SWORN TO before me this 18th day of June, 1938

My commission expires My Commission Expires Mar. 25, 1942

Henry
Robt
Notary Public.