

STATE OF KANSAS
STATE CORPORATION COMMISSION

WELL PLUGGING RECORD

Give All Information Completely.
Make Required Affidavit
Mail or Deliver Report to:
Conservation Division
State Corporation Commission
800 Bitting Building
Wichita, Kansas

OR
FORMATION PLUGGING RECORD

Strike out upper line
when reporting plug-
ging of formations.

NORTH R13W

Stafford County, Sec. 14 Twp. 22S Rge. (E) 13 (W)

Location as "NE $\frac{1}{4}$ NW $\frac{1}{4}$ SW $\frac{1}{4}$ " or footage from lines NW/4 NW/4 NE/4

Lease Owner Stanolind Oil and Gas Company

Lease Name E. Fischer Well No. 1

Office Address Box 591, Tulsa, Oklahoma

Character of Well (completed as Oil, Gas or Dry Hole) Dry Hole

Date, well completed June 2, 1938

T Application for plugging filed December 30, 1939

22 Application for plugging approved January 2, 1940

S Plugging Commenced January 2, 1940

Plugging Completed January 10, 1940

Reason for abandonment of well or producing formation Non Producer

If a producing well is abandoned, date of last production None 193...

Was permission obtained from the Conservation Division or its agents before plugging was commenced? Yes

Name of Conservation Agent who supervised plugging of this well C. T. Alexander

Producing formation Arbuckle Depth to top 3776 Bottom 3805 Total Depth of Well 3805 Feet

Show depth and thickness of all water, oil and gas formations.

OIL, GAS OR WATER RECORDS


CASING RECORD

Formation	Content	From	To	Size	Put In	Pulled Out
Arbuckle	Salt Water	3776	3805	10 3/4" OD 6" OD	258'2" 3796'5"	None 1867.73'

Describe in detail the manner in which the well was plugged, indicating where the mud fluid was placed and the method or methods used in introducing it into the hole. If cement or other plugs were used, state the character of same and depth placed, from...feet to ...feet for each plug set.

Heavy Mud 3770'-3805'
 6 Sacks Cement 3755'-3770'
 Heavy Mud 265'-3755'
 Field Rock 250'-265'
 13 Sacks Cement 235'-250'
 Heavy Mud 6'-235'
 8 Sacks Cement 4'-6'
 Earth Fill in Cellar 0'-4' 1-19-40

FILE 14-22-13W
 23-LINE-37

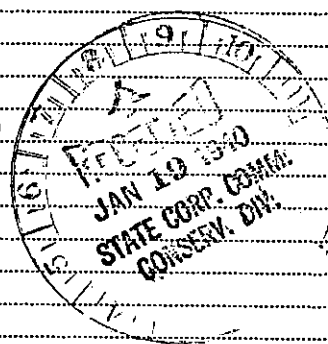

(If additional description is necessary, use BACK of this sheet)

Correspondence regarding this well should be addressed to Frank Pickell
Address Box 591, Tulsa, Oklahoma

STATE OF Kansas, COUNTY OF Barton, ss.

C. D. Kerr (employee of owner) or (owner or operator) of the above-described well,

being first duly sworn on oath, says: That I have knowledge of the facts, statements, and matters herein contained and the log of the above-described well as filed and that the same are true and correct. So help me God.

(Signature) C. D. Kerr

Ellinwood, Kansas

(Address)

SUBSCRIBED AND SWORN to before me this 15th day of January, 1940

Joan A. Wiley

Notary Public.

My commission expires May 3, 1941