


STATE OF KANSAS
STATE CORPORATION COMMISSION

Give All Information Completely
Make Required Affidavit
Mail or Deliver Report to:
Conservation Division
State Corporation Commission
800 Bittling Building
Wichita, Kansas

WELL PLUGGING RECORD
OR
FORMATION PLUGGING RECORD

Strike out upper line
when reporting plug-
ging off formations.

NORTH

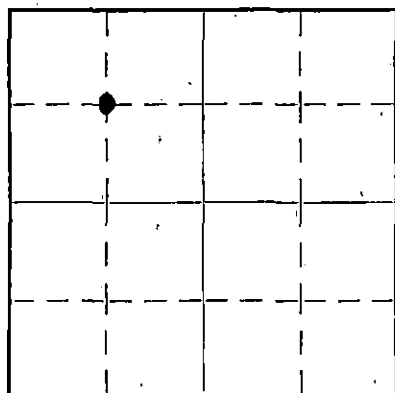

Locate well correctly on above
Section Plat

Harvey County, Sec. 11 Twp. 23 Rge. 2 (E) (W)

Location as "NE $\frac{1}{4}$ NW $\frac{1}{4}$ SW $\frac{1}{4}$ " or footage from lines
Lease Owner Anna Stauffer
Lease Name Stauffer Well No. 1
Office Address
Character of Well (Completed as Oil, Gas or Dry Hole) Dry Hole
Date, well completed August 2, 1929 193
Application for plugging filed 193
Application for plugging approved 193
Plugging Commenced December 12, 1946 193
Plugging Completed December 27, 1946 193
Reason for abandonment of well or producing formation Dry
If a producing well is abandoned, date of last production 193
Was permission obtained from the Conservation Division or its agents before plugging was commenced?
Yes

Name of Conservation Agent who supervised plugging of this well Ruel Durkee
Producing formation Depth to top Bottom Total Depth of Well Feet
Show depth and thickness of all water, oil and gas formations.

OIL, GAS OR WATER RECORDS

CASING RECORD

Formation	Content	From	To	Size	Put In	Pulled Out
Shale				10"	143'	None
Lime		220	235	7"	224'	None

Describe in detail the manner in which the well was plugged, indicating where the mud fluid was placed and the method or methods used in introducing it into the hole. If cement or other plugs were used, state the character of same and depth placed, from feet to feet for each plug set.

The above well was plugged and abandoned as a dry hole in 1929. At the request of the Conservation Division of the Corporation Commission of the State of Kansas, December 12, 1946, the well was re-opened and replugged as follows: The well was cleaned out and 10" Casing drove to a total depth of 143'. Changed to 8" Tools. Well cleaned out with 8" Tools from 143' to a total depth of 230' at which depth a rock bridge was set. 7" O.D. Casing run to 224' and cemented with 75 Sacks of cement from bottom to top. Cement circulated.

Original well drilled by The McPherson Oil & Gas Development Company.

(If additional description is necessary, use BACK of this sheet)

Correspondence regarding this well should be addressed to The Kansas Power and Light Company, Box 59, Salina, Kansas
Address

STATE OF Kansas, COUNTY OF McPherson, SS.
C. H. Smith (employee of owner) or (owner or operator) of the above-described well,
being first duly sworn on oath, says: That I have knowledge of the facts, statements, and matters herein contained and the log of the above-described well as filed and that the same are true and correct. So help me God.

(Signature)

McPherson, Kansas

(Address)

SUBSCRIBED AND SWORN to before me this 31st day of December, 1946

My commission expires January 10, 1949

17-932 9-37-5M

Notary Public.