

STATE OF KANSAS
STATE CORPORATION COMMISSION

WELL PLUGGING RECORD


NOV 13 1937

Give All Information Completely
Make Required Affidavit
Mail or Deliver Report to:
Conservation Division
State Corporation Commission
800 Bittling Building
Wichita, Kansas

OR
FORMATION PLUGGING RECORD

Strike out upper line
when reporting plug-
ging off formations.

NORTH

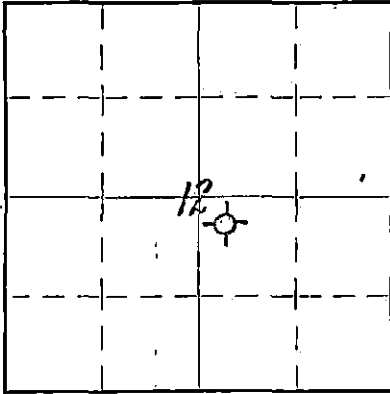

Locate well correctly on above
Section Plat

Location as "NE $\frac{1}{4}$ NW $\frac{1}{4}$ SW $\frac{1}{4}$ " or footage from lines NW SE
Harvey County. Sec. 12 Twp. 23 Rge. 2 (E) W (W)

Lease Owner H.M. Steel
Lease Name Steel #1 Well No. 1
Office Address 609-611 Wolcott Bldg Hutchinson, Kas.
Character of Well (Completed as Oil, Gas or Dry Hole) Dry Hole
Date, well completed 5/2/37 193.
Application for plugging filed 5/2/37 193.
Application for plugging approved 5/4/37 193.
Plugging Commenced 5/6/37 193.
Plugging Completed 5/6/37 193.
Reason for abandonment of well or producing formation Dry Hole

If a producing well is abandoned, date of last production ✓ 193.
Was permission obtained from the Conservation Division or its agents before plugging was commenced? Yes

Name of Conservation Agent who supervised plugging of this well Mr Russell
Producing formation Siliceous Depth to top 3540 Bottom Total Depth of Well 3615 Feet.

Show depth and thickness of all water, oil and gas formations.

OIL, GAS OR WATER RECORDS

CASING RECORD

Formation	Content	From	To	Size	Put In	Pulled Out
<u>Chat</u>	<u>Water</u>	<u>3075</u>	<u>3105</u>	<u>12 1/2"</u>	<u>153'</u>	

Describe in detail the manner in which the well was plugged, indicating where the mud fluid was placed and the method or methods used in introducing it into the hole. If cement or other plugs were used, state the character of same and depth placed, from feet to feet for each plug set.

Heavy mud was pumped into hole to fill it to the bottom of the surface pipe (3462') on top of which a 15' cement plug was placed (138'-153') and heavy mud was pumped into surface pipe and a 10' cement plug placed on top (0-103) after a steel plate was welded on top of surface pipe and the collar cemented

Recd 11-13-37

PLUGGING
FILE SEC 12-23-2W
BOOK PAGE 87 LINE 23

pd 11/13/37
Ho

(If additional description is necessary, use BACK of this sheet)

Correspondence regarding this well should be addressed to G.W. Shaffer, Jr.
Address 609 Wolcott Bldg. Hutchinson, Kas.

STATE OF Kansas, COUNTY OF Pena, ss.
George W. Shaffer, Jr., (employee of owner) or (owner or operator) of the above-described well,
being first duly sworn on oath, says: That I have knowledge of the facts, statements, and matters herein contained and the log of the above-described well as filed and that the same are true and correct. So help me God.

(Signature) George W. Shaffer, Jr.
609 Wolcott Bldg. Hutch. Kas. (Address)

SUBSCRIBED AND SWORN TO before me this 12th day of November, 1937.

My commission expires Jan 19, 1941

Leville Warren
Notary Public.

NOV 13 1937

E. J. SHAFER

DRILLING CONTRACTOR

305 Hoke Building

Hutchinson, Kansas

May 27, 1937

STEELE #1 WELL

Sec. 12, Twp. 23, R. 2W
Harvey County, Kansas

15-079-19150-0000

Rig Started: 4-2-37
Rig Completed: 4-4-37
Drilling started: 4-4-37
Drilling Completed: 5-2-37

LOG

0 - 8	Clay	
40	Clay	
148	Shale & Shells	
475	Shale & Shells	
625	Shale & Lime	- - - - - Driftmeter test 0 degrees off.
700	Broken Lime	
725	Shale	
745	Lime	
770	Lime	
845	Lime & Shale	
900	Lime	
925	Shale	
950	Shale	
975	Lime	
1030	Shale	- - - - - Driftmeter test 1 degree off.
1190	Shale	
1330	Shale	
1480	Shale	
1565	Shale	- - - - - Driftmeter test 1 degree off.
1690	Shale	
1820	Shale	
1910	Shale & Shells	
2000	Shale	- - - - - Driftmeter test 1 degree off.
2120	Shale	
2200	Lime & Shale	
2225	Lime	
2260	Shale	
2320	Shale	
2355	Lime	
2425	Broken Lime	
2520	Broken Lime & Shale	
2560	Lime	
2620	Lime	
2670	Lime	
2720	Lime	
2805	Lime & Shale	
2850	Shale & Shells	
2903	Shale	
2942	Shale	
2965	Shale	
2985	Shale	
3015	Shale	
3032	Chert	
3066	Shale & Shells	
3079	Broken Lime & Chert	
3130	Broken Lime	
3180	Lime	
3206	Broken Lime	

FILE SET 12-23-2W
BOOK PAGE 87-LINE 23

NOV 13 1937

LOG ON STEELE #1 WELL, May 27, 1937

3228	Line
3258	Broken Line
3266	Hard Sand Lime
3284	Line
3322	Line
3328	Shale & Shells
3331	Sandy Shale
3346	Shale (cored)
3361	Sand
3363	Chert
3430	Broken Lime
3437	Broken Lime & Sand
3439	Lime & Shale
3447	Lime & Shale
3450	Lime
3473	Line
3495	Shale & Shells
3497	Sand
3505	Shale & Dolomite
3509	Dolomite Sand
3515	Sand
3520	Sand (cored)
3528	Sandy Lime (cored)
3533	Sandy Lime & Shale (cored)
3536	Broken Lime
3540	Sand
3548	Lime
3551	Lime
3555	Lime-Hard (cored)
3561	Lime-Soft (cored)
3570	Lime & Shale
3575	Hard Lime
3610	Lime
3615	Lime

FILE NO. 12,23,2W
BOOK PAGE 87 LINE 2-3

SET 153' OF 12 $\frac{1}{2}$ " O. D. CASING AND CEMENTED WITH 150 SACKS OF LONE STAR CEMENT @ 8:15 P. M.
4-5-37. HALLIBURTON METHOD.

State of Kansas }
County of Reno } SS

I, the undersigned, being duly sworn on oath, state that the above and within statement is a true and correct record and log of the well drilled on the location above described, to the best of my knowledge and belief.

E. J. Shaffer
E. J. SHAFFER

Subscribed and sworn to before me this 29 day of May 1937
My Commission expires 9/17/41

L. O. Anderson
NOTARY PUBLIC