

15-079-20014-0000
Form CP-4


STATE OF KANSAS
STATE CORPORATION COMMISSION

Give All Information Completely
Make Required Affidavit
Mail or Deliver Report for
Conservation Division
State Corporation Commission
212 No. Market
Wichita, Kansas

WELL PLUGGING RECORD

Harvey County, Sec. 12 Twp. 23S Rge. 2 ~~12~~ W (W)

Location as "NE/CNW/SW" or footage from lines SE W/2 SW
Lease Owner Frank Black
Lease Name Denno Well No. 1
Office Address McPherson, Kansas 67460
Character of Well (completed as Oil, Gas or Dry Hole) Oil
Date well completed 6-16-67 19
Application for plugging filed 10-10-68 19
Application for plugging approved 10-11-68 19
Plugging commenced 10/12/68 19
Plugging completed 10/17/68 19
Reason for abandonment of well or producing formation depleted.

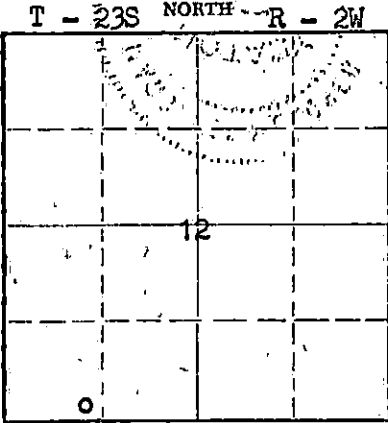

Locate well correctly on above Section Plat

If a producing well is abandoned, date of last production 19
Was permission obtained from the Conservation Division or its agents before plugging was commenced? yes

Name of Conservation Agent who supervised plugging of this well Scott
Producing formation Depth to top Bottom Total Depth of Well 2984 Feet
Show depth and thickness of all water, oil and gas formations.

OIL, GAS OR WATER RECORDS CASING RECORD

FORMATION	CONTENT	FROM	TO	SIZE	PUT IN	PULLED OUT
				8-5/8	164'	none
				5 1/2	2979'	2223'

Describe in detail the manner in which the well was plugged, indicating where the mud fluid was placed and the method or methods used in introducing it into the hole. If cement or other plugs were used, state the character of same and depth placed, from feet to feet for each plug set.

Checked hole to 2984', ran sand to 2950' and ran 5 sacks of cement. Shot pipe at 2500', 2400', 2309', 2217', worked pipe loose and pulled 55 joints. Pulled 14 more joints. Set 10' rock bridge at 180' and ran 25 sacks of cement. Mudded to 40', set 10' rock bridge and ran 10 sacks of cement. Tallied pipe.

PLUGGING COMPLETE.

RECEIVED
STATE CORPORATION COMMISSION
OCT 21 1968
CONSERVATION DIVISION
Wichita, Kansas

(If additional description is necessary, use BACK of this sheet)
Name of Plugging Contractor KNIGHT CASING PULLING CO., INC. License #436
Address CHASE, KANSAS

STATE OF KANSAS, COUNTY OF RICE, ss.
NOEL J. KNIGHT (employee of owner) or (owner or operator) of the above-described well, being first duly sworn on oath, says: That I have knowledge of the facts, statements, and matters herein contained and the log of the above-described well as filed and that the same are true and correct. So help me God.

(Signature) Noel Knight
CHASE, KANSAS (Address)

MARGARET MELCHER
NOTARY PUBLIC
WICHITA, KANSAS
2/15/73
My commission expires

SUBSCRIBED AND SWORN TO before me this 18th day of October, 1968
Margaret Melcher Notary Public.

KANSAS GEOLOGICAL SOCIETY
 KANSAS WELL LOG BUREAU - KANSAS WELL SAMPLE BUREAU
 KANSAS GEOLOGICAL SOCIETY BUILDING
 508 EAST MURDOCK - WICHITA, KANSAS

15-079-20014-0000

COMPANY Lewis Short

SEC. 12 T. 23S R. 2W

FARM Denno NO. 1

LOC. SE/4 of W/2 of SW/4

TOTAL DEPTH 2984

COUNTY Harvey


COMM. 6-5-67

COMP. 6-16-67

SHOT OR TREATED

CONTRACTOR SeRoBee Drilling Co., Inc.

ISSUED

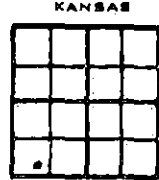

CASING

20	10		
15	8	-5/8" - 164' w/150 sx cement	ELEVATION 1451
12	6		
13	5	1/2" ID - 2979' - 100 sx cement	PRODUCTION Oil

FIGURES INDICATE BOTTOM OF FORMATIONS

0	-	625	Shale & Shells
625	-	700	Shale & Lime
700	-	825	Lime
825	-	855	Lime & Shale
855	-	1000	Lime
1000	-	2468	Lime & Shale
2468	-	2880	Lime
2880	-	2984	Miss.

Geological Tops

Heebner	2119
Douglas	2174
Lansing	2350
Base/KC	2742
Miss.	2977

RECEIVED
 STATE CORPORATION COMMISSION
OCT 21 1968
 CONSERVATION DIVISION
 Wichita, Kansas

I certify the above to be a true and correct copy of the geological tops and driller's log to the best of my knowledge and belief.

Paul S. Septer

Paul S. Septer