


WELL PLUGGING RECORD 15-155-20123-0000

Give All Information Completely  
Make Required Affidavit  
Mail or Deliver Report to:  
Conservation Division  
State Corporation Commission  
212 No. Market  
Wichita, Kansas

NORTH

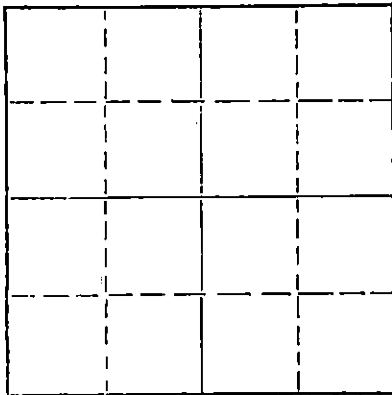

Locate well correctly on above  
Section Plat

Reno County: Sec. 32 Twp. 23S Rge. 10W X8 (W)  
Location as "NE/CNW/SW" or footage from lines 1220' fr. W.L. & 2540' fr. NL  
Lease Owner Independent Lease Management Company  
Lease Name Banz Well No. 1  
Office Address 800 Wichita Plaza, Wichita, Kansas  
Character of Well (completed as Oil, Gas or Dry Hole) Dry Hole  
Date well completed July 24 19 69  
Application for plugging filed \_\_\_\_\_ 19\_\_\_\_  
Application for plugging approved \_\_\_\_\_ 19\_\_\_\_  
Plugging commenced July 24 19 69  
Plugging completed July 24 19 69  
Reason for abandonment of well or producing formation Dry Hole

If a producing well is abandoned, date of last production \_\_\_\_\_ 19\_\_\_\_  
Was permission obtained from the Conservation Division or its agents before plugging was commenced? \_\_\_\_\_

Name of Conservation Agent who supervised plugging of this well \_\_\_\_\_  
Producing formation \_\_\_\_\_ Depth to top \_\_\_\_\_ Bottom \_\_\_\_\_ Total Depth of Well 3762 Feet  
Show depth and thickness of all water, oil and gas formations.

OIL, GAS OR WATER RECORDS

CASING RECORD

FORMATION	CONTENT	FROM	TO	SIZE	PUT IN	PULLED OUT
				8 5/8	265'	None

Describe in detail the manner in which the well was plugged, indicating where the mud fluid was placed and the method or methods used in introducing it into the hole. If cement or other plugs were used, state the character of same and depth placed, from \_\_\_\_\_ feet to \_\_\_\_\_ feet for each plug set.

Filled hole to 210' w/heavy mud w/  
1/2 sx. hulls & 25 sx. cement.  
Filled hole to 40' w/1/2 sx. hulls & 10  
sx. cement to surface.

RECEIVED  
STATE CORPORATION COMMISSION  
AUG 14 1969  
CONSERVATION DIVISION  
Wichita, Kansas

(If additional description is necessary, use BACK of this sheet)

Name of Plugging Contractor Kathol Petroleum, Inc.  
Address 900 Sutton Place, Wichita, Kansas

STATE OF Kansas, COUNTY OF Sedgwick, ss.  
Dale P. Jewett (employee of owner) or (owner or operator) of the above-described well, being first duly sworn on oath, says: That I have knowledge of the facts, statements, and matters herein contained and the log of the above-described well as filed and that the same are true and correct. So help me God.

(Signature) Dale P. Jewett  
800 Wichita Plaza  
(Address)

SUBSCRIBED AND SWORN to before me this 13th day of August, 19 69

My commission expires June 9, 1973

Paul E. Crayton  
Notary Public.

AUG 11 1969

DRILLERS LOG

15-155-20123-0000

#1 BANZ

CASING RECORD: OPERATOR: Independent Lease Mgmt. DESCRIPTION:  
 8 5/8" @ 265' w/ 225 sacks cement CONTRACTOR: Kathol Petroleum, Inc. 1220' fr. W.L. & 2540' fr. N.L.  
 COMMENCED: July 17, 1969 Sec. 32-23S-10W Reno Co., Kansas  
 TOTAL DEPTH: COMPLETED: July 24, 1969  
 3762' I.P. D. & A. ELEVATION:

FORMATION	FROM	TO	REMARKS
surface soil	0	265	
shale	265	465	
shale & red bed	465	1330	
shale & shells	1330	1465	
shale & lime strks.	1465	1775	
shale & lime	1775	1875	
lime	1875	1970	
lime & shale	1970	2120	
shale & lime	2120	2925	
lime & shale	2925	3055	
lime	3055	3140	
lime & shale	3140	3250	
lime	3250	3315	
lime & shale	3315	3480	
lime	3480	3550	
lime & shale	3550	3630	
lime	3630	3762 R.T.D.	

RECEIVED  
 STATE CORPORATION COMMISSION  
 AUG 14 1969  
 CONSERVATION DIVISION  
 Wichita, Kansas

I hereby certify that the above information is true and correct to the best of my knowledge.

KATHOL PETROLEUM, INC.

*Don D. Shawver*  
 Don D. Shawver

Subscribed and sworn to before me this 6th day of August, 1969.

*Betty M. Maloney*  
 Betty M. Maloney, Notary Public

My Commission Expires:

