


WELL PLUGGING RECORD

Give All Information Completely
Make Required Affidavit
Mail or Deliver Report to:
Conservation Division
State Corporation Commission
800 Bittling Building
Wichita, Kansas

NORTH

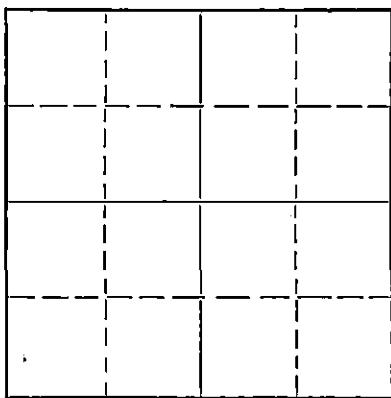

Locate well correctly on above
Section Plat

Reno County. Sec. 32 Twp. 23 Rge. 10 (E) West (W)
Location as "NE/CNW $\frac{1}{4}$ /SW $\frac{1}{4}$ " or footage from lines 990' S. & 330' E. of W/4 Cor.
Lease Owner Cities Service Oil Company
Lease Name Masemore Well No. 2
Office Address Bartlesville, Oklahoma
Character of Well (completed as Oil, Gas or Dry Hole) Oil Well
Date well completed January 5, 19 44
Application for plugging filed March 2, 19 53
Application for plugging approved March 3, 19 53
Plugging commenced March 11, 19 53
Plugging completed March 16, 19 53
Reason for abandonment of well or producing formation Depleted formation.

If a producing well is abandoned, date of last production January 10, 19 53
Was permission obtained from the Conservation Division or its agents before plugging was commenced? Yes

Name of Conservation Agent who supervised plugging of this well Russ Durkee
Producing formation Viola Depth to top 3662 Bottom 3730 Total Depth of Well 3730 Feet
Show depth and thickness of all water, oil and gas formations. P.B.T.D. 3715'

OIL, GAS OR WATER RECORDS

CASING RECORD

Formation	Content	From	To	Size	Put In	Pulled Out
				8-5/8"	269'	None
				5-1/2"	3715'	3141'

Describe in detail the manner in which the well was plugged, indicating where the mud fluid was placed and the method or methods used in introducing it into the hole. If cement or other plugs were used, state the character of same and depth placed, from _____ feet to _____ feet for each plug set.

3715-3650, 6 sacks cement and sand.
3650- 200, mud.
200- 150, rock bridge and 15 sacks cement.
150- 20', mud.
20' to base of cellar, 5 sacks cement.

3-21-53

FILED
STATE OF KANSAS
MAR 21 1953
CONSERVATION DIVISION
WICHITA, KANSAS

(If additional description is necessary, use BACK of this sheet)
Name of Plugging Contractor C. E. Skull Casing Pulling Co.
Address Great Bend, Kansas

STATE OF Kansas COUNTY OF Barton, ss.
V. M. Conover (employee of owner) or (owner/proprietor) of the above-described well,

being first duly sworn on oath, says: That I have knowledge of the facts, statements, and matters herein contained and the log of the above-described well as filed and that the same are true and correct. So help me God.

(Signature) V. M. Conover
Box 751, Great Bend, Kansas
(Address)

SUBSCRIBED AND SWORN TO before me this 19th day of March 19 53
W. B. Smith
Notary Public.

My commission expires March 12, 1955.
23-8390-s 6-51-20M

PLUGGING
FILE SEC 32 T 23 R 10 W
BOOK PAGE 82 LINE 6

15-155-62287-0000

Company Cities Service Oil Co. Well No. 2 Farm Massmore
 Location 990' South and 330' East of W/4 Corner Sec. 32 T. 23 R. 10W
 Elevation 1792 County Reno State Kansas
 Initial Prod. BHP Gauge Potential: 1349 oil, 0 water, calc. gas Drig. Co. Corbett-Barbour Drig. Co.
 Acid 500 gals. 1-15-44 Drig. Comm. December 19, 1943
 T. D. 3730' Drig. Comp. January 5, 1944

CASING RECORD:

8-5/8" @ 264' cem. 140 ex Lehigh cem.
 5-1/2" @ 3719' cem. 100 ex cement.

Top Viola 3662'
 Penetration 68'
 Total Depth 3730'

FORMATION RECORD:

sand 0-150
 red bed 500
 red bed, shale & shells 875
 shale & shells 1050
 salt & shale 1350
 broken lime & shale 1395
 anhydrite & lime 1490
 lime 1720
 lime & shale 1875
 lime 1960
 lime & shale 2030
 broken lime 2105
 lime & shale 2200
 shale & lime 2310
 lime & shale 2525
 shale & lime 2540
 lime & shale 2620
 shale & lime 2855
 lime 2975
 lime & shale 3050
 shale & lime 3195
 lime & shale 3245
 lime 3640
 shale & shells 3650
 lime, sand, shale & chert 3677
 lime & chert 3730 T. D.

Drilled cement to 3715 S. L. H.
 Loaded hole with 2500' water.
 Perforated 46 shots 3705-13.
 Swabbed 2 bbl. oil per hour.

Slope Tests (Acid Bottle):

500' OK
 1000' OK
 1500' OK
 2000' OK
 2500' OK
 3000' OK
 3500' OK

PLUGGING

FILE SEC 32T23R10W
 BOOK PAGE 22 LINE 6

RECORDED
 STATE COMMISSION
 CONSERVATION DIVISION
 Wichita, Kansas