

STATE OF KANSAS
STATE CORPORATION COMMISSION


Give All Information Completely
Make Required Affidavit
Mail or Deliver Report to:
Conservation Division
State Corporation Commission
800 Pitting Building
Wichita, Kansas

WELL PLUGGING RECORD

Stafford County, Sec. 17 Twp. 22S Rge. (E) 13(W)

Location as "NE/CNW/SW" or footage from lines SW SW NW
Lease Owner Natural Gas and Oil Corporation
Lease Name Tuggle Well No. 1
Office Address 1009 Central Building, Wichita 2, Kansas
Character of Well (completed as Oil, Gas or Dry Hole) dry hole
Date well completed June 7, 1954 19
Application for plugging filed (Orally) June 7, 1954 19
Application for plugging approved " June 7, 1954 19
Plugging commenced June 7, 1954 19
Plugging completed June 7, 1954 19
Reason for abandonment of well or producing formation _____

NORTH

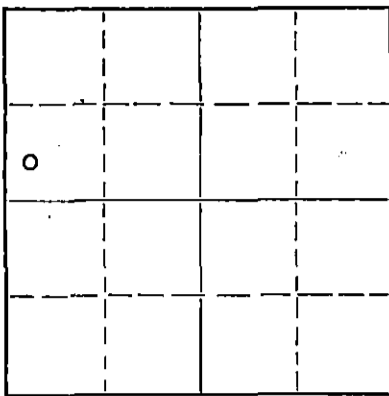

Locate well correctly on above
Section Plat

If a producing well is abandoned, date of last production _____ 19
Was permission obtained from the Conservation Division or its agents before plugging was commenced? yes

Name of Conservation Agent who supervised plugging of this well _____
Producing formation _____ Depth to top _____ Bottom _____ Total Depth of Well _____ Feet
Show depth and thickness of all water, oil and gas formations.

OIL, GAS OR WATER RECORDS

CASING RECORD

FORMATION	CONTENT	FROM	TO	SIZE	PUT IN	PULLED OUT
surface		0	328	328'	of 8 5/8'	none

Describe in detail the manner in which the well was plugged, indicating where the mud fluid was placed and the method or methods used in introducing it into the hole. If cement or other plugs were used, state the character of same and depth placed, from _____ feet to _____ feet for each plug set.

Filled hole with heavy mud; from total depth 3876 to 320 feet
Set plug at 320 feet and ran 15 sacks cement to 270 feet
Filled with heavy mud from 270 feet to 20 feet
Set plug at 20 feet and ran 10 sacks cement to cellar

RECEIVED
STATE CORPORATION COMMISSION

JUN 10 1954

CONSERVATION DIVISION
Wichita, Kansas

(If additional description is necessary, use BACK of this sheet)

Name of Plugging Contractor Drilling Department of Natural Gas and Oil Corporation
Address 1009 Central Building, Wichita 2, Kansas

STATE OF Kansas, COUNTY OF Sedgwick, ss.
John D. Carey (employee of owner) or ~~(owner)~~ of the above-described well, being first duly sworn on oath, says: That I have knowledge of the facts, statements, and matters herein contained and the log of the above-described well as filed and that the same are true and correct. So help me God.

(Signature) John D. Carey
1009 Central Building, Wichita 2, Kansas
(Address)

SUBSCRIBED AND SWORN TO before me this 9th day of June, 1954

Esther Unsell
Esther Unsell Notary Public.

My commission expires May 25, 1957

PLUGGING
FILE SEC 17 T 22 R 13W
BOOK PAGE 39 LINE 44

DRILLER'S LOG

COMPANY: Natural Gas and Oil Company
a division of
Mississippi River Fuel Corporation
FARM: Tuggle #1, SW SW NW Sec. 17-22S-13W
Stafford County, Kansas
CONTRACTOR: Drilling Department of
Natural Gas and Oil Company
COMMENCED: May 28, 1954
COMPLETED: June 7, 1954
ELEVATION: 1915 RB.

0 to 9 Cellar
9 to 180 Sand
180 to 250 Shale and sand
250 to 450 Shale and shells
450 to 780 Shale-shells-red bed
780 to 805 Anhydrite
805 to 1250 Shale and shells
1250 to 1440 Salt and shale
1440 to 1640 Shale and shells
1640 to 1900 Shale and lime
1900 to 1940 Lime
1940 to 3255 Shale and lime
3255 to 3315 Lime
3315 to 3424 Shale and lime
3424 to 3727 Lime
3727 to 3800 Chert and lime
3800 to 3837 Shale
3837 to 3876 Arbuckle Lime
3876 T. D.

Set 328 feet of 8 5/8" 24# surface pipe. Cemented with 300 sacks cement and 4 sacks calcium chloride.

Drill Stem Test 3840-48, open 1 1/4 hours, rec. 990 feet sulphur water, SI 1/2 hr, (fair to good blow) 60# IFP, 180# FFP, BHP did not record.

TOPS:	Anhydrite 780	Lans-KC 3438	Simpson 3790
	Heebner 3291	Base KC 3658	Arbuckle 3840
	Brown Lime 3423	Viola 3740	

Ran Schlumberger
DRY, PLUGGED AND ABANDONED

RECEIVED
CORPORATION COMMISSION

C E R T I F I C A T E JUN 17 1954

I, John D. Carey, do hereby certify that the above and foregoing is a true and correct copy of the log of the Tuggle #1, SW SW NW Section 17-22S-13W, Stafford County, Kansas, as reflected by files of the Natural Gas and Oil Company, a division of, Mississippi River Fuel Corporation.

John D. Carey
John D. Carey

Subscribed and sworn to before me, a Notary Public, within and for Sedgwick County, Kansas, this 9th day of June, 1954.

Esther Unsell
Esther Unsell, Notary Public

My commission expires May 25, 1957.

PLUGGING
FILE SEC L2 22 13W
COPY PAGE 39 LINE 44