


STATE OF KANSAS
STATE CORPORATION COMMISSION

WELL PLUGGING RECORD

Give All Information Completely
Make Required Affidavit
Mail or Deliver Report to
Conservation Division
State Corporation Comm.
245 North Water
Wichita, KS 67202

Stafford County, Sec. 17 Twp. 22S Rge. 13W E/W
Location as "NE/CNW $\frac{1}{4}$ /SW $\frac{1}{4}$ " or footage from lines
NE SW NE
Lease Owner Halliburton Oil Producing Co.
Lease Name Keller Well No. 1
Office Address 2915 Classen Blvd. Okla. City, Okla. 73106
Character of Well (Completed as Oil, Gas or Dry Hole) Dry Hole
Date Well completed 5-29-79 19
Application for plugging filed 5-29-79 19
Application for plugging approved 5-29-79 19
Plugging commenced 5:30 P. M. 5-29-79 19
Plugging completed 7:00 P. M. 5-29-79 19
Reason for abandonment of well or producing formation _____

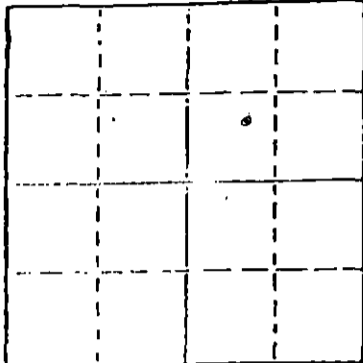

Locate well correctly on above
Section Plat

If a producing well is abandoned, date of last production 19 _____

Was permission obtained from the Conservation Division or its agents before plugging was commenced? Yes

Name of Conservation Agent who supervised plugging of this well WM. T. Owen
Producing formation _____ Depth to top _____ Bottom _____ Total Depth of Well 3885'
Show depth and thickness of all water, oil and gas formations.

OIL, GAS OR WATER RECORDS

CASING RECORD:

FORMATION	CONTENT	FROM	TO	SIZE	PUT IN	PULLED OUT

Describe in detail the manner in which the well was plugged, indicating where the mud fluid was placed and the method or methods used in introducing it into the hold. If cement or other plugs were used, state the character of same and depth placed, from _____ feet to _____ feet for each plug set.

Mud To 540' 40 sacks 50-50 Posmix
Mud To 300' 40 Sacks 50-50 Posmix
Mud To 40' 12 Sacks 50-50 posmix
3 Sacks In Rat Hole

6-5-79

RECEIVED
STATE CORPORATION COMMISSION

(If additional description is necessary, use BACK of this sheet)
Name of Plugging Contractor _____ JUN - 5 1979

STATE OF Kansas COUNTY OF Barton CONSERVATION DIVISION
Wichita, Kansas
Clyde Merckle (employee of owner) or (owner or operator)
of the above-described well, being first duly sworn on oath, says: That I have knowledge of the facts, statements, and matters herein contained and the log of the above-described well as filed and that the same are true and correct. So help me God.

(Signature) Clyde Merckle
(Address) _____

AND SWORN TO before me this 4th day of June, 1979.
William D. Kules
Notary Public.
My commission expires April 11, 1981



Halliburton Oil Producing Co.
2915 Classen Blvd.
Oklahoma City, Oklahoma 73106

Keller #1

NE SW NE Section 17 22 South 13 West

Stafford County

Driller's Log - Total 3885

0 - 250	Sand
250 - 760	Red Bed and Shale
760 - 790	Anhydrite
790 - 2150	Red Bed and Shale
2150 - 3450	Shale and Lime
3450 - 3885	Lime

Clyde V. Merckle
Clyde V. Merckle

RECEIVED
STATE CORPORATION COMMISSION

JUN - 5 1979

CONSERVATION DIVISION
Wichita, Kansas