

NOTICE OF INTENTION TO DRILL

Must be approved by the K.C.C. five (5) days prior to commencing well

Expected Spud Date May 15, 1991
month day year

291'S8& 53'E of East
C-W/2.NW.SW... Sec 32.. Twp 16. S, Rg 11.. X West

OPERATOR: License # 7030
Name: JOHN ROY EVANS
Address: P. O. Box 385
City/State/Zip: Clafflin, Kansas 67525
Contact Person: John R. Evans
Phone: 316/587-3565

1689 feet from South line of Section
4897 feet from East line of Section
(Note: Locate well on Section Plat on Reverse Side)

CONTRACTOR: License #: 5929
Name: DUKE DRILLING CO., INC.

County: Barton
Lease Name: Schneweiss Well #: 1
Field Name: Kraft-Prusa
Is this a Prorated Field? yes X no
Target Formation(s): Lansing
Nearest lease or unit boundary: 383'
Ground Surface Elevation: Unknown feet MSL
Domestic well within 330 feet: yes X no
Municipal well within one mile: yes X no
Depth to bottom of fresh water: 230'
Depth to bottom of usable water: 430'
Surface Pipe by Alternate: X 1 2
Length of Surface Pipe Planned to be set: 450'
Length of Conductor pipe required: N/A
Projected Total Depth: 3400'
Formation at Total Depth: Arbuckle
Water Source for Drilling Operations:
well farm pond X other
DWR Permit #: _____
Will Cores Be Taken?: yes X no
If yes, proposed zone: _____

Well Drilled For: Well Class: Type Equipment:
X Oil ... Inj X Infield X Mud Rotary
... Gas ... Storage ... Pool Ext. ... Air Rotary
... OWWO ... Disposal ... Wildcat ... Cable
... Seismic; ... # of Holes

If OWWO: old well information as follows:
Operator: _____
Well Name: _____
Comp. Date: _____ Old Total Depth _____

Directional, Deviated or Horizontal wellbore? yes X no
If yes, total depth location: _____

*WAS: surface pipe req = 600
IS: surface pipe req = 450*

AFFIDAVIT

Alt I completion only

The undersigned hereby affirms that the drilling, completion and eventual plugging of this well will comply with K.S.A. 55-101, et. seq.

It is agreed that the following minimum requirements will be met:

1. The appropriate district office shall be notified before setting surface pipe;
2. The minimum amount of surface pipe as specified above shall be set by circulating cement to the top; in all cases surface pipe shall be set through all unconsolidated materials plus a minimum of 20 feet into the underlying formation;
3. If the well is dry, a plugging proposal shall be submitted to the district office. An agreement between the operator and the district office on plug length and placement is necessary prior to plugging;
4. The appropriate district office will be notified before well is either plugged or production casing is cemented in;
5. If an Alternate II completion, production pipe shall be cemented from below any usable water to surface within 120 days of spud date. In all cases, notify district office prior to any cementing.

I hereby certify that the statements made herein are true and to the best of my knowledge and belief.

Date: May 10, 1991 Signature of Operator or Agent: Sally R. Byers Title: Agent

RECEIVED
STATE CORPORATION COMMISSION
MAY 13 1991
CONSERVATION DIVISION
Wichita, Kansas

FOR KCC USE:
API # 15- 009-24,473 0000
Conductor pipe required None feet
Minimum surface pipe required 1 feet per Alt. 1
Approved by: DDW 5-13-91; can 5-21-91
EFFECTIVE DATE: 5-18-91
This authorization expires: 11-13-91
(This authorization void if drilling not started within 6 months of effective date.)
Spud date: _____ Agent: _____

REMEMBER TO:

- File Drill Pit Application (form CDP-1) with Intent to Drill;
- File Completion Form ACO-1 within 120 days of spud date;
- File acreage attribution plat according to field proration orders;
- Notify appropriate district office 48 hours prior to workover or re-entry;
- Submit plugging report (CP-4) after plugging is completed;
- Obtain written approval before disposing or injecting salt water.

*32
16
11W*


PLAT OF ACREAGE ATTRIBUTABLE TO A WELL

State Corporation Commission, Conservation Division
200 Colorado Derby Bldg. Wichita, Kansas 67202

OPERATOR JOHN ROY EVANS LOCATION OF WELL:
 LEASE SCHNEWEISS 1689 feet north of SE corner
 WELL NUMBER 1 4897 feet west of SE corner
 FIELD KRAFT-PRUSA SW/4 Sec. 32 T 16S R 11 ~~EW~~
 COUNTY Barton
 NO. OF ACRES ATTRIBUTABLE TO WELL 10 IS SECTION X REGULAR IRREGULAR?
 DESCRIPTION OF ACREAGE SW/4 IF IRREGULAR, LOCATE WELL FROM NEAREST
 CORNER BOUNDARY.

NOTE: If plat depicted is insufficient for your circumstances, you may attach your own scaled or surveyed plat.

PLAT

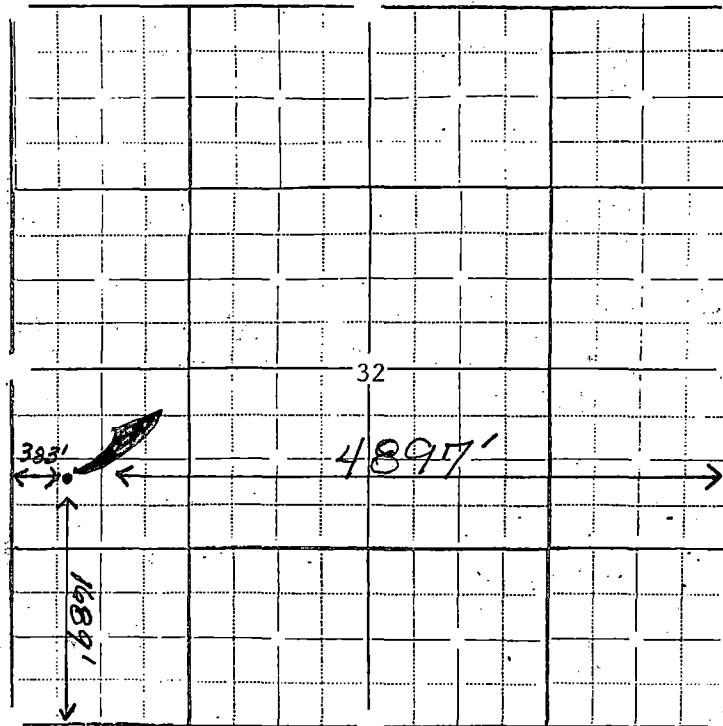

In plotting the proposed location of the well, you must show:

- 1) The manner in which you are using the depicted plat by identifying section lines, i.e. 1 section, 1 section with 8 surrounding partial sections, 4 sections, 16 sections, etc.;
- 2) the well's location relative to the location of other wells producing from the same common source of supply in adjoining drilling units, pursuant to K.A.R. 82-3-108, 82-3-207, 82-3-312, or special orders of the Commission;
- 3) the distance of the proposed drilling location from the section's east and south lines; and
- 4) the distance to the nearest lease or unit boundary line.

I hereby certify that the statements made herein are true and to the best of my knowledge and belief.

Signature of Operator or Agent *Sally A. Byers*
 Date May 10, 1991 Title AGent