

CARD MUST BE TYPED

State of Kansas
NOTICE OF INTENTION TO DRILL

CARD MUST BE SIGNED

Starting Date: August 17 1984
month day year

API Number 15- 097-21,012-0000

CORRECTION 21754

OPERATOR: License # 5171
Name TXO Production Corp.
Address 200 West Douglas, Suite 300
City/State/Zip Wichita, KS 67202
Contact Person Gary Murdeman
Phone 316-265-9441

150' SW C SW SE Sec 1 Twp 28 S, Rge 16
(location) East West

* 560 Ft North from Southeast Corner of Section
**2080 Ft West from Southeast Corner of Section
(Note: Locate well on Section Plat on reverse side)

CONTRACTOR: License # 5107
Name H-30 Drilling
City/State Wichita, Ks.

Nearest lease or unit boundary line 560 feet.

County Kiowa

Lease Name BINFORD "B" Well# 1

Domestic well within 330 feet: yes no

Municipal well within one mile: yes no

Well Drilled For: Well Class: Type Equipment:
 Oil Swd Infield Mud Rotary
 Gas Inj Pool Ext. Air Rotary
 OWWO Expl Wildcat Cable

Depth to Bottom of fresh water 100 feet

Lowest usable water formation Unknown

Depth to Bottom of usable water 200 feet

Surface pipe by Alternate: 1 2

Surface pipe to be set 400 feet

Conductor pipe if any required 0 feet

Ground surface elevation TBD feet MSL

This Authorization Expires 8-2-84

Approved By J. J. [Signature]

If OWWO: old well info as follows:

Operator

Well Name

Comp Date Old Total Depth

Projected Total Depth 4750 feet

Projected Formation at TD Kinderhook Sand

Expected Producing Formations Kinderhook Sand

I certify that we will comply with K.S.A. 55-101, et seq., plus eventually plugging hole to K.C.C. specifications.


Date 8-16-84 Signature of Operator or Agent

*Correct from 660' **Correct from 2310'
J. J. [Signature] Drlg. & Completion Engineer

Must be filed with the K.C.C. five (5) days prior to commencing well
This card void if drilling not started within six (6) months of date received by K.C.C.

Important procedures to follow :

**A Regular Section of Land
1 Mile = 5,280 Ft.**

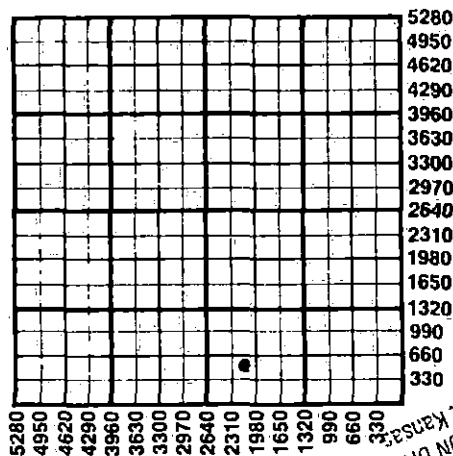

1. Notify District office before setting surface casing.
2. Set surface casing by circulating cement to the top.
3. File completion forms ACO-1 with K.C.C. within 90 days of well completion, following instructions on ACO-1, side 1, and including copies of wireline logs.
4. Notify District office 48 hours prior to old well workover or re-entry.
5. Prior to plugging, prepare a plugging plan, then obtain agreement from the appropriate district office for an approved plugging plan.
6. Submit plugging report (CP-4) to K.C.C. after plugging is completed.
7. Obtain an approved injection docket number before disposing of salt water.
8. Notify K.C.C. within 10 days when injection commences or terminates.
9. If an alternate 2 completion, cement in the production pipe from below any usable water to surface within 120 days of spud date.

State Corporation Commission of Kansas
Conservation Division
200 Colorado Derby Building
Wichita, Kansas 67202
(316) 263-3238

CONSERVATION DIVISION
WICHITA, KANSAS
AUG 17 1984
STATE CORPORATION COMMISSION
RECEIVED
8-17-84