

CARD MUST BE TYPED

State of Kansas
NOTICE OF INTENTION TO DRILL
(see rules on reverse side)

CORRECTION

CARD MUST BE SIGNED

Starting Date: August 15, 1985
month day year

REPLACEMENT

OPERATOR: License # 6892
WENEZT Name TRICH PRODUCTION, INC. OIL GAS

API Number 15-097-21133 See Surface Casing Depth 6000
SW SE 4 28S 16W East
(Location) Sec Twp S, Rge West

Address P. O. Box 1408
City/State/Zip Longview, Texas 75606
Contact Person Ed Leith
Phone 316/733-4911

467 Ft North from Southeast Corner of Section
1980 Ft West from Southeast Corner of Section
(Note: Locate well on Section Plat on reverse side)

CONTRACTOR: License # 5829
Name ALDEBARAN DRILLING CO., INC.
City/State Wichita, Kansas

Nearest lease or unit boundary line 467 feet.
County Kiowa

Well Drilled For: Well Class: Type Equipment:
 Oil Swd Infield Mud Rotary
 Gas Inj Pool Ext. Air Rotary
 OWWO Expl Wildcat Cable

Lease Name KENDALL Well# 2
Domestic well within 330 feet: yes no ?
Municipal well within one mile: yes no ?

If OWWO: old well info as follows:
Operator
Well Name
Comp Date Old Total Depth
Projected Total Depth 4800 feet
Projected Formation at TD Mississippi
Expected Producing Formations Mississippi

Depth to Bottom of fresh water 100 200 feet
Lowest usable water formation
Depth to Bottom of usable water 300 feet
Surface pipe by Alternate: 1 2
* Surface pipe to be set 250X 391 feet
Conductor pipe if any required feet
Ground surface elevation 2125 feet MSI.
This Authorization Expires 10-16-85
Approved By PC# 8-12-85 DRIG RCU# 4-16-85

I certify that we will comply with K.S.A. 55-101, et seq., plus eventually plugging hole to K.C.C. specifications.

Date 8-20-85 Signature of Operator or Agent

Ed Leith
Title

Supervisor

RECEIVED
STATE CORPORATION COMMISSION

Must be filed with the K.C.C. five (5) days prior to commencing well
This card void if drilling not started within six (6) months of date received by K.C.C.


AUG 22 1985

8-22-85

CONSERVATION DIVISION

A Regular Section of Land

1 Mile = 5,280 Ft.

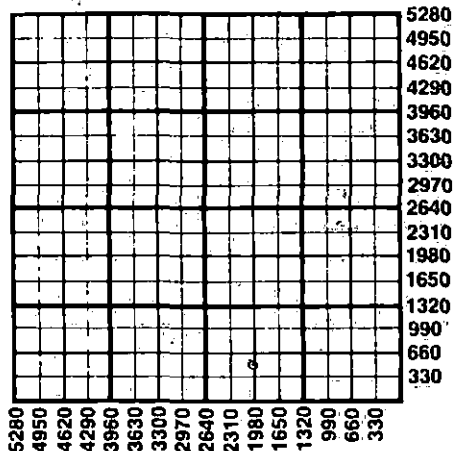

Important procedures to follow :

1. Notify District office before setting surface casing.
2. Set surface casing by circulating cement to the top.
3. File completion forms ACO-1 with K.C.C. within 90 days of well completion, following instructions on ACO-1, side 1, and including copies of wireline logs.
4. Notify District office 48 hours prior to old well workover or re-entry.
5. Prior to plugging, prepare a plugging plan, then obtain agreement from the appropriate district office for an approved plugging plan.
6. Submit plugging report (CP-4) to K.C.C. after plugging is completed.
7. Obtain an approved injection docket number before disposing of salt water.
8. Notify K.C.C. within 10 days when injection commences or terminates.
9. If an alternate 2 completion, cement in the production pipe from below any usable water to surface within 120 days of spud date.

State Corporation Commission of Kansas
Conservation Division
200 Colorado Derby Building
Wichita, Kansas 67202
(316) 263-3238