


STATE OF KANSAS
STATE CORPORATION COMMISSION

Give All Information Completely
Make Required Affidavit
Mail or Deliver Report to:
Conservation Division
State Corporation Commission
212 No. Market
Wichita, Kansas

WELL PLUGGING RECORD

NORTH

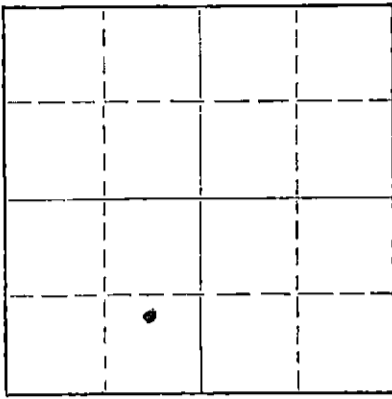

Locate well correctly on above
Section Plat

Reno County, Sec. 6 Twp. 22 Rge. (E) 9 (W)
Location as "NE/CNW/SW" or footage from lines N/2 SE SW
Lease Owner Harms Petroleum Company
Lease Name Culver Well No. 2
Office Address Box 488, Great Bend, Kansas
Character of Well (completed as Oil, Gas or Dry Hole) oil
Date well completed 19__
Application for plugging filed December 14 1967
Application for plugging approved 19__
Plugging commenced February 27 1967
Plugging completed February 29 1967
Reason for abandonment of well or producing formation depleted

If a producing well is abandoned, date of last production 19__
Was permission obtained from the Conservation Division or its agents before plugging was commenced? yes

Name of Conservation Agent who supervised plugging of this well Gilbert Toman
Producing formation _____ Depth to top _____ Bottom _____ Total Depth of Well 3621 Feet
Show depth and thickness of all water, oil and gas formations.

OIL, GAS OR WATER RECORDS

CASING RECORD

FORMATION	CONTENT	FROM	TO	SIZE	PUT IN	PULLED OUT
		0	220'	8 5/8"	220'	none
		0	3612'	5 1/2"	3612'	3028.90

Describe in detail the manner in which the well was plugged, indicating where the mud fluid was placed and the method or methods used in introducing it into the hole. If cement or other plugs were used, state the character of same and depth placed, from _____ feet to _____ feet for each plug set.

Sand back to 3600' and dumped 5 sacks cement.

Set bridge from 210' to 200'; mixed and dumped 20 sacks cement.
Filled hole with mud to 40', set 10' rock bridge and capped hole with 10 sacks cement.

RECEIVED
STATE CORPORATION COMMISSION
MAR 8 - 1968
CONSERVATION DIVISION
Wichita, Kansas

(If additional description is necessary, use BACK of this sheet)
Name of Plugging Contractor Pipe Pullers, Inc.
Address Box 486, Ellinwood, Kansas

STATE OF Kansas, COUNTY OF Barton, ss.
Ed Schonhoff (employee of owner) or (owner or operator) of the above-described well, being first duly sworn on oath, says: That I have knowledge of the facts, statements, and matters herein contained and the log of the above-described well as filed and that the same are true and correct. So help me God.

(Signature) E. L. Schonhoff
Ellinwood, Kansas (Address)

SUBSCRIBED AND SWORN TO before me this 4th day of March, 1968

My commission expires July 7, 1968

Notary Public.

DRILLERS LOG

Company: Lee Phillips Oil Company
 Farm: Culver #2
 Commenced: October 19, 1959

N/2 SE SW Section 6-22-9W
 Reno County, Kansas
 Completed: October 29, 1959

Elevation 1751 KB

0 - 120	sand
120 - 160	shale sand
160 - 360	red bed
360 - 385	anhydrite
385 - 900	red bed and shale
900 - 1225	shells & shale
1225 - 2120	lime & shale
2120 - 2655	shale & lime
2655 - 2780	lime-shale
2780 - 2924	lime
2924 - 2925	Haebner shale
2929 - 2975	lime
2975 - 3068	shale-Douglas
3068 - 3412	lime
3412 - 3450	lime-chert
3450 - 3517	lime & shale
3517 - 3606	Viola lime
3606 - 3621	coring
3621	Total depth

RECEIVED
 STATE CORPORATION COMMISSION

DEC 15 1961

CONSERVATION DIVISION
 Wichita, Kansas

Set 220 feet 8 5/8" surface casing. Cemented with 200 sacks of common cement with 2% calcium chloride.

Tops: Anhydrite	-	360
Haebner	-	2924
Brown lime	-	3065
Lansing KC	-	3092
Viola	-	3517

Ran 5 1/2" casing to 3612'. Cemented with 75 sacks common cement.

AFFIDAVIT

STATE OF KANSAS)
)SS
 COUNTY OF BARTON)

I, Allan Harms of the Harms-Burt Drilling Company being first duly sworn on oath state: I have knowledge of the facts, statements and matters herein contained and the same are true and correct.

Subscribed and sworn to before me this 23 day of November, 1959

Allan Harms
Mary E. Van Pelt

My commission expires January 20, 1962.